

WATER SERVICE RECORD

Name DeVries Const. Co. Inc.

Service No. 157

280
281
9693

Address 23 Minute Man Lane

Location Lexington

~~RENEWAL~~ New Service

Com. 8-10-53

Date	Material	Amount	Total	Date	Amount
7/10/53	Labor	1 75		6-10-53	Deposited 20 00
	10% overhead	18	1 93	8-24-53	Paid (6 64
	55'-3/4" Copper Tubing @.3629		19 96		NON CHARGE 26 64
	1-3/4" C. x 1/2 I.W.H. STOP & WASTE		4 00	Labor 7/10/53	9 19
	1 Hr. Trucking		75	12'-3/4" Copper Tubing @.3629	4 35
			26 64	1-3/4" C. Corp-cock	4 33
	TRENCH DUG BY OWNER			1-3/4" C. x 3/4" C. Curb-cock	4 67
				1-Box & Fpd	3 90
				1-1/2 straight tail piece	50
				1-1/2 offset tail piece	50
				1 Hr. Trucking	75
					28 19


bill sent 8-11-53

DATE _____

TOWN OF LEXINGTON — BOARD OF PUBLIC WORKS

WATER DIVISION

Sketch of Service Here

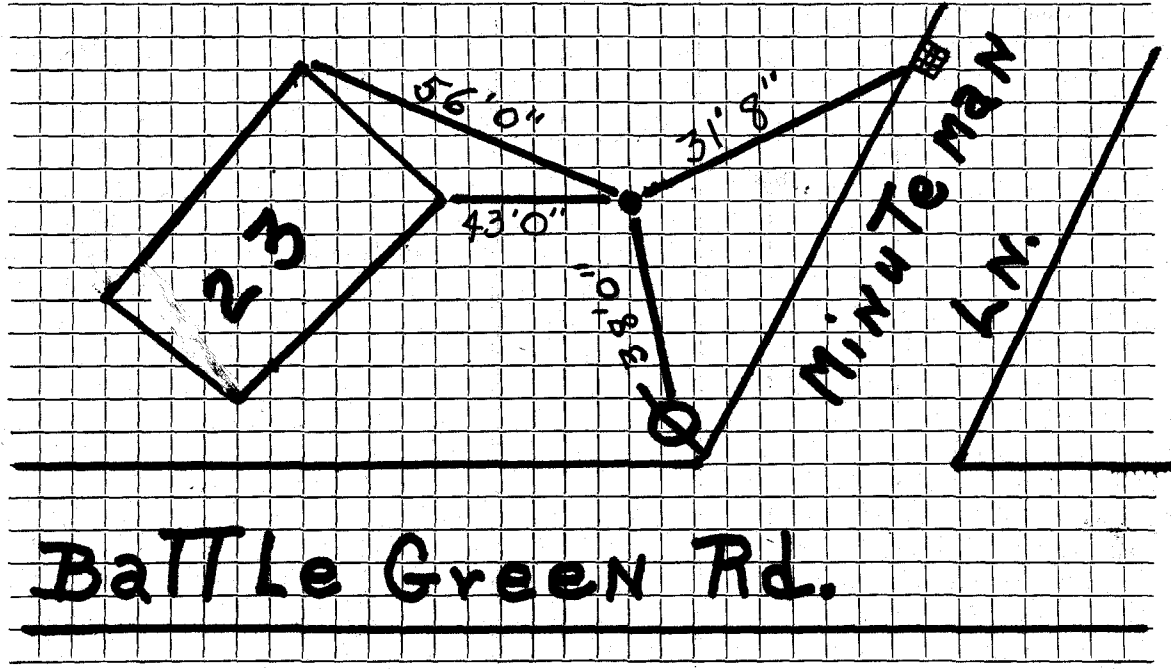

BATTLE GREEN RD.

Connection made in Street. Work completed

Remarks:
.....
.....