

## WATER SERVICE RECORD

Name

*William Phablia*

Service No.

*30*

Address

*#3 A Minute Man Lane*

Location

Repair—Renewal—New Service

*Ferrari Plumbing & Heating # 2389*

FEB 10 1975


Date	Material	Amount	Total	Date	Amount	
				<i>12-4-73</i>	<i>Deposit</i>	<i>150.00</i>
<i>1-28-73</i>	<i>527' - 1" Copper</i>			<i>5-10-75</i>	<i>Retuned</i>	<i>39.80</i>
<i>12-12-'73</i>	Labor	\$18.72				<i>110.30</i>
	10% O.H.	1.87	\$20.59			
	<i>33' copper</i> 1 1/2" Tubing	@1.35	44.55			
	1 1" Corporation		13.79			
	1 1" Curb Cock		14.43			
	1 Box & Rod		7.34			
	1 Hr. Trucking		3.00			
	1 Hr. Town Shovel		<u>6.50</u>			
			\$110.20			

DATE \_\_\_\_\_

# TOWN OF LEXINGTON — BOARD OF PUBLIC WORKS

## WATER DIVISION

Sketch of Service Here  
#3A Minute Man  
Cane.  
-25'-

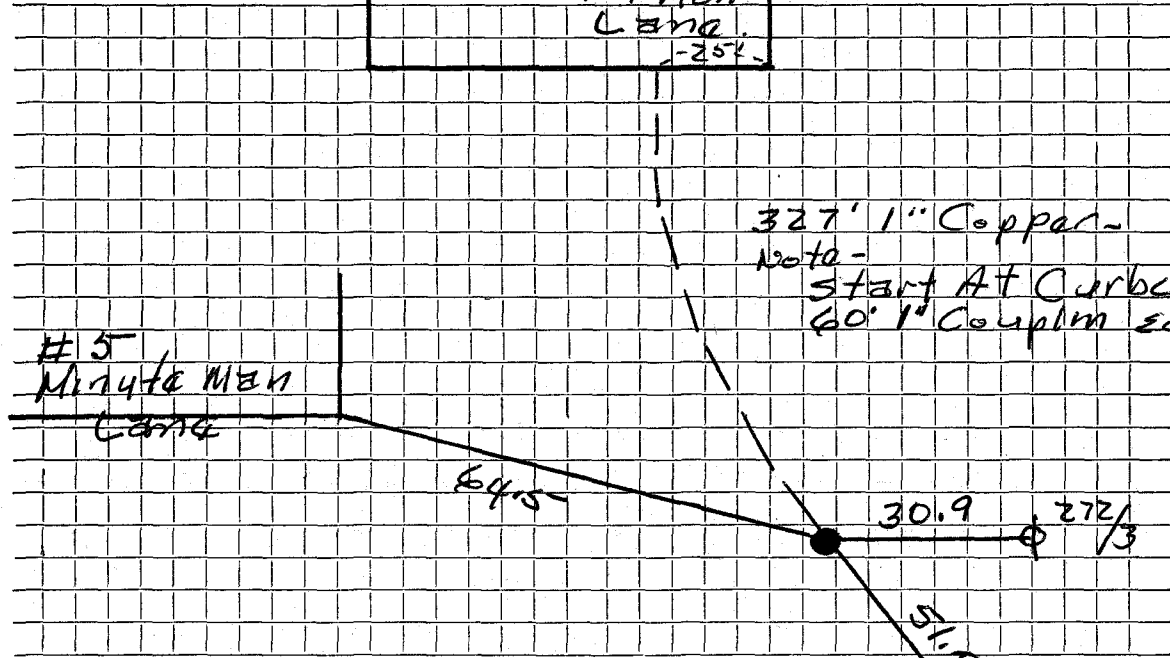

Connection made in ..... Street. Work completed .....

Remarks: .....  
.....  
.....