

WATER SERVICE RECORD

4836

Name DeVries Const. Co., Inc.

Service No. 145

Address 5th Inute Man Lane

Location

~~Repair~~ ~~Service~~ - New Service

Per. 8-10-53

| Date | Material | Amount | Total | Date | Amount |
|---------|--------------------------------------|--------|-------|----------------------------------|--------|
| 6/27/53 | Labor | 1 75 | | 6-10-53 | 20 00 |
| | 10% overhead | 18 | 1 93 | 8-24-53 | 1 20 |
| | 40' - 3/4" copper tubing @ .3629 | 14 52 | | | 21 20 |
| | 1 - 3/4" C x 1/2 I.W.H. stop & waste | | 4 00 | 6/27/53 | 4 49 |
| | 1 hr. trucking | | 75 | 21' - 3/4" copper tubing @ .3629 | 7 62 |
| | | | 21 20 | 1 - 3/4" C. corp-cock | 4 33 |
| | TRENCH DUG BY OWNER: | | | 1 - 3/4" C x 3/4" C. curb-cock | 4 67 |
| | | | | 1 box and rod | 3 90 |
| | | | | 1 - 1/2 straight tail pc. | 50 |
| | | | | 1 - 1/2 offset tail pc. | 50 |
| | | | | 1 hr. trucking | 75 |
| | | | | | 26 76 |

Deposited
Paid
NON CHARGE


bill sent 8-11-53

DATE _____

TOWN OF LEXINGTON — BOARD OF PUBLIC WORKS

WATER DIVISION

Sketch of Service Here

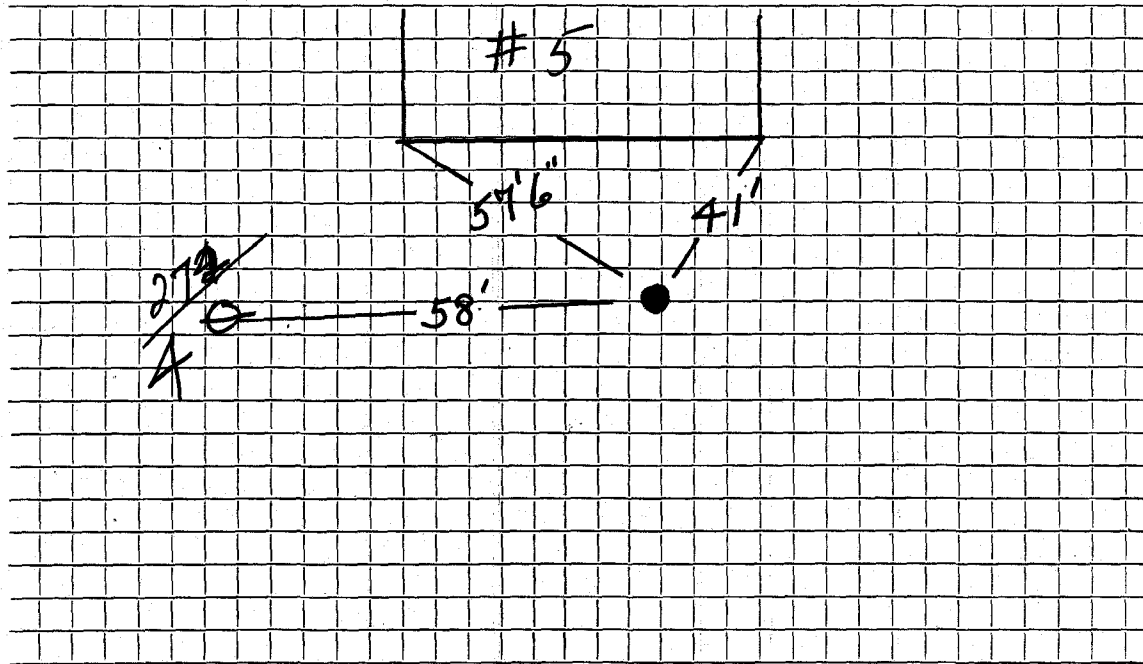

Connection made in Street. Work completed

Remarks:

.....
.....