




DATE \_\_\_\_\_

# TOWN OF LEXINGTON — BOARD OF PUBLIC WORKS

## WATER DIVISION

Sketch of Service Here BALL FIELD

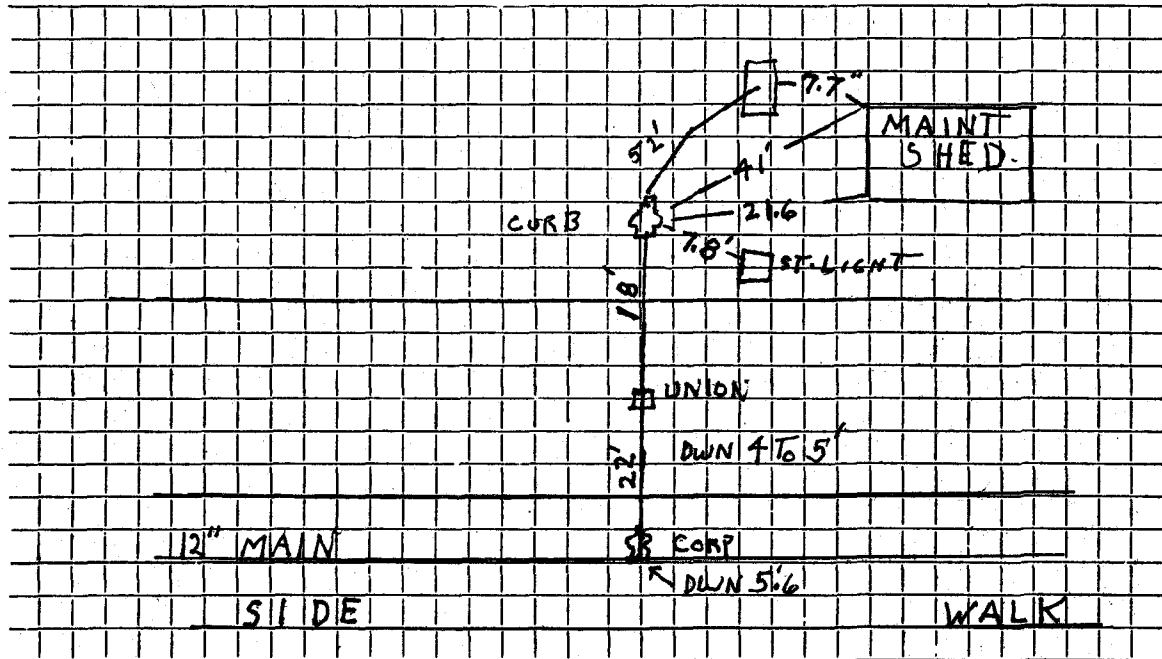

Connection made in School DR. Street. Work completed .....

Remarks: CORP. TAP AT UPWARD ANGLE. GREEN HOUSE SIDE OF SCHOOL .....