




DATE Nov. 1964

TOWN OF LEXINGTON — BOARD OF PUBLIC WORKS

WATER DIVISION

Sketch of Service Here

3 MOHAWK

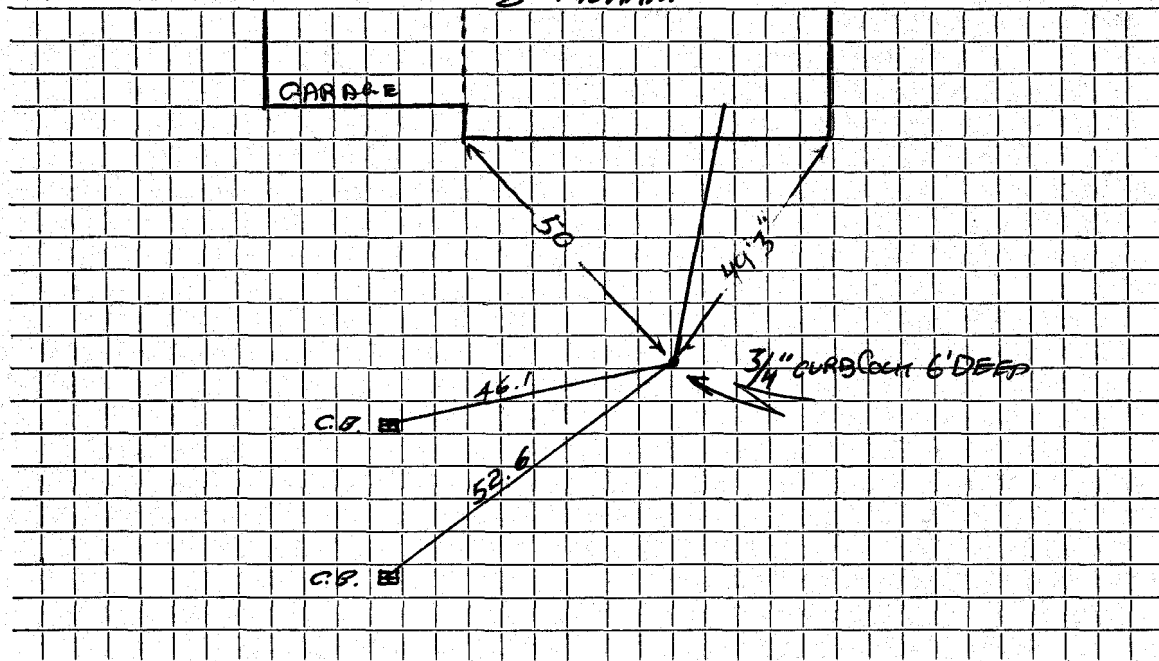

Connection made in MOHAWK DR Street. Work completed OCT 3, 1983

Remarks: WATER & SEWER SERVICE IN SAME TRENCH FROM MAIN TO EDGE OF ROAD