


DATE _____

TOWN OF LEXINGTON — BOARD OF PUBLIC WORKS

WATER DIVISION

Sketch of Service Here

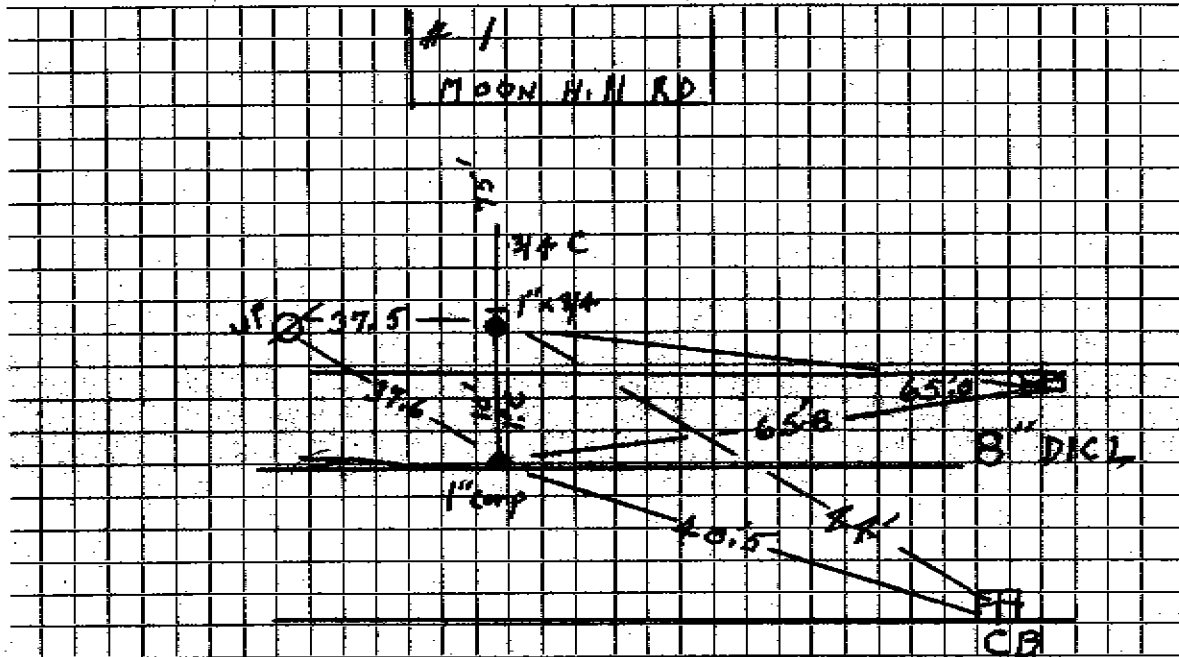

Connection made in..... Street.

Work completed 6/8/08 Pao. Corp.

Remarks: 1\"