




DATE \_\_\_\_\_

# TOWN OF LEXINGTON — BOARD OF PUBLIC WORKS

## WATER DIVISION

Sketch of Service Here

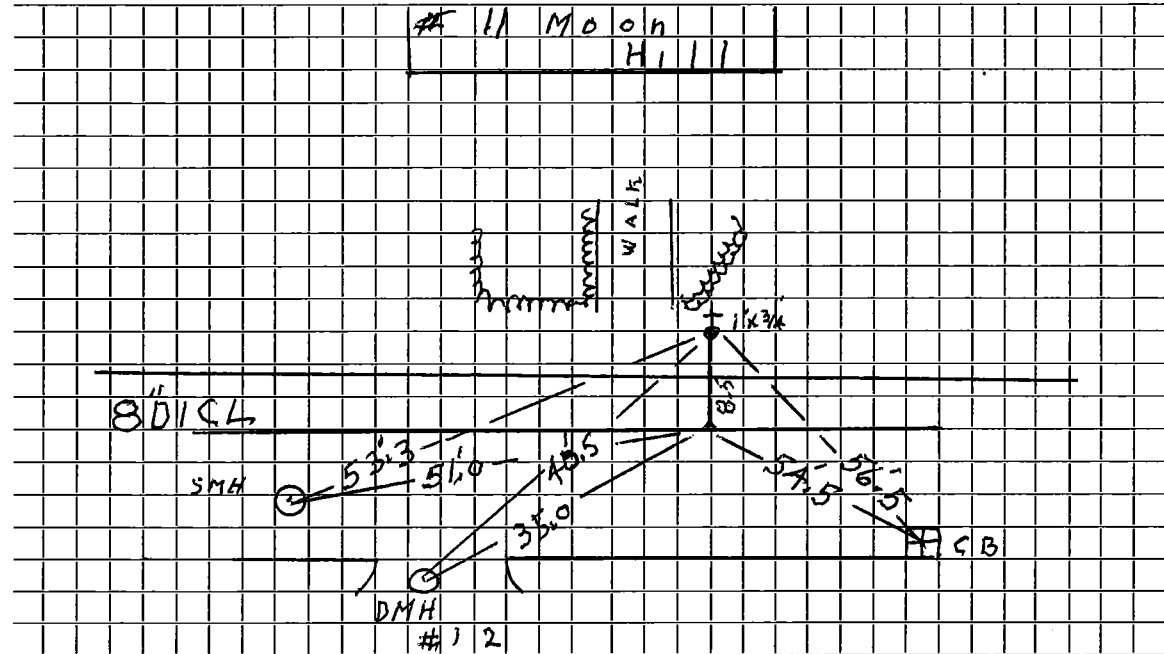

Connection made in..... Street.

Work completed 6/5/09 P.A.O. Corp.....

Remarks:.....

.....

.....