


DATE _____

TOWN OF LEXINGTON — BOARD OF PUBLIC WORKS

WATER DIVISION

Sketch of Service Here

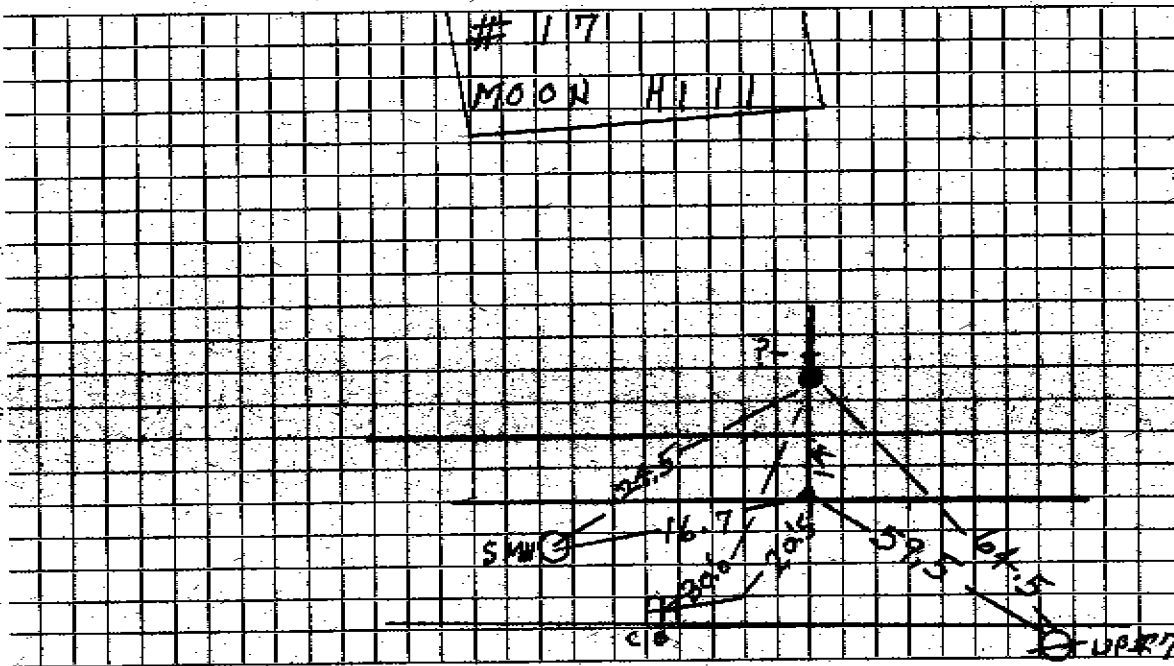

Connection made in Street. Work completed 6/4/09 PAO, Corp.

Remarks: Old Card has 3/4" copper / NEW 1" Shows (2)" Union