


DATE _____

TOWN OF LEXINGTON — BOARD OF PUBLIC WORKS

WATER DIVISION

Sketch of Service Here

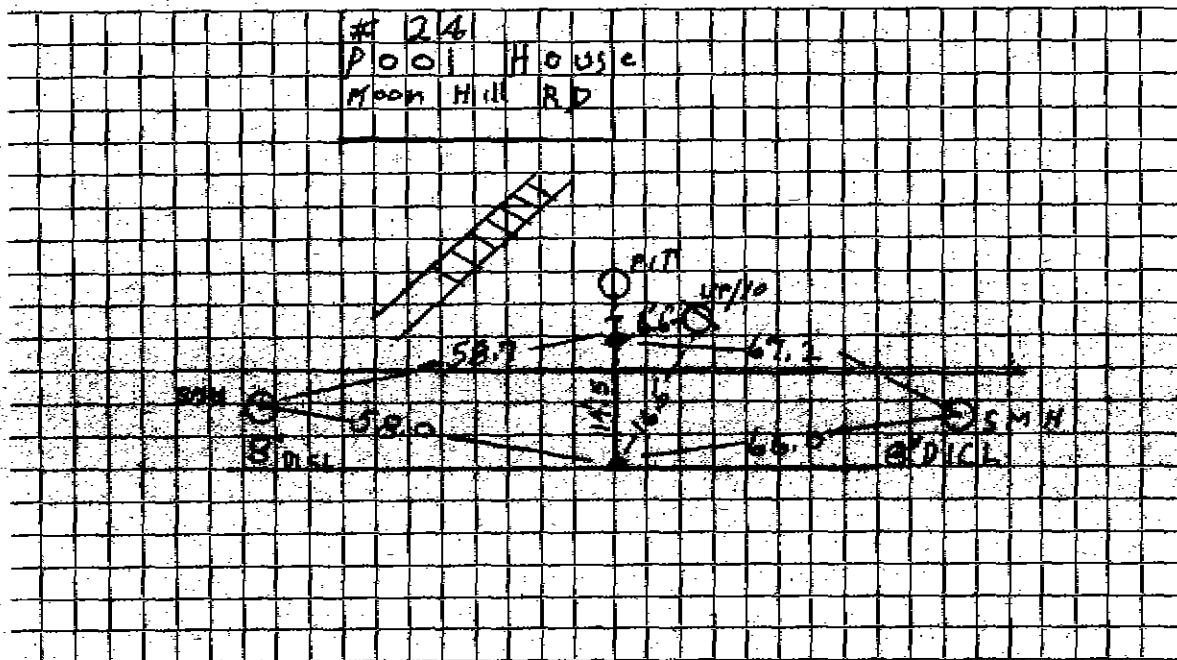

Connection made in Street. Work completed 6/3/09 P.A.O.

Remarks: Curb 3' 8" DWN.

.....

.....