


DATE

TOWN OF LEXINGTON — BOARD OF PUBLIC WORKS

WATER DIVISION

Sketch of Service Here

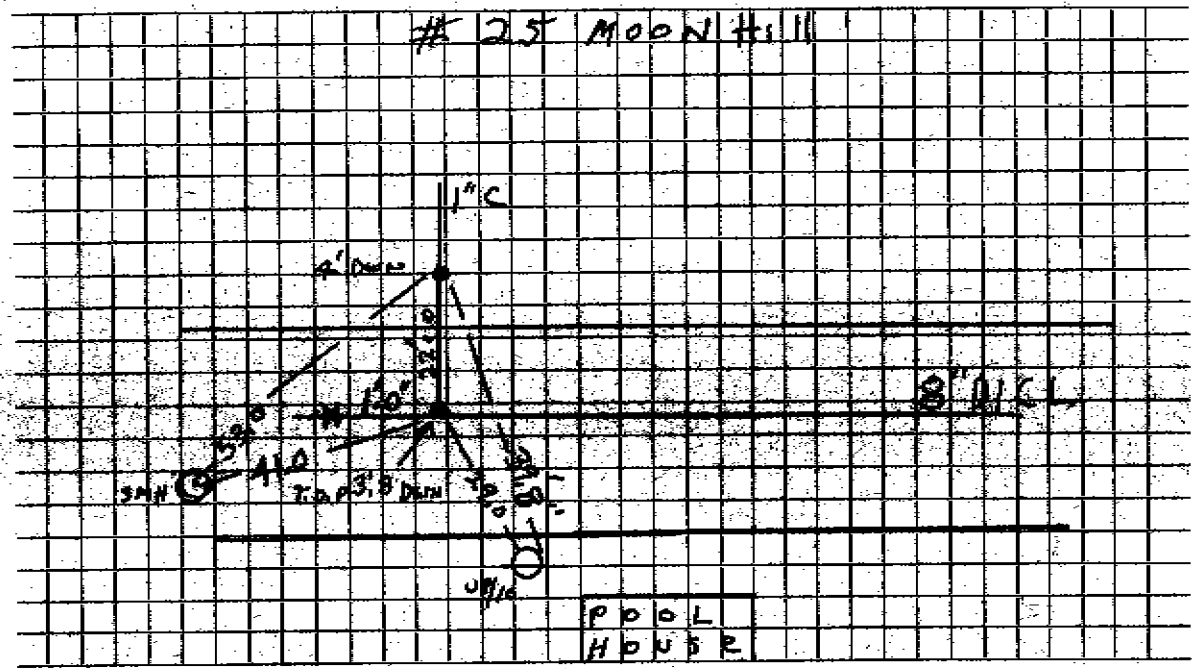

Connection made in Street.

Work completed 6/2/09 PAO.

Remarks: Sewer Repair - 6" PVC, From Clay to PVC