

WATER SERVICE RECORD

4907

Name W. D. Elmer

Service No. 57

Address 28 Moon Hill Road

Location Lexington, Mass.

Repair/ Renewal - New Service


Com. 8-6-50

Date	Material	Amount	Total	Date	Amount
4-18-51	Labor	5 40	5 40	4-10-51	Deposited 65 00
	10% Overhead		54		
	45' - 3/4" Copper Tubing @.36	16 20			No Charge
	1 - 3/4" C x 1/2" I.W.H. S&W		4 00	4-18-51	Labor 5 40
	Littlefield Shovel 2 hrs, @7.00	14 00			27' - 3/4" Copper Tubing @.36 9 72
	Trucking 1 hr. @.75		75		1 - 3/4" C Corp-cock 4 33
	Patching 20 x 3		20 00		1 - 3/4" C x 3/4" Curb-cock 4 67
			60 89		1 - Box & Rod 4 68
					1 - 1/2" Offset Tail Piece 50
					1 - 1/2" Straight Tail Piece 50
					Littlefield Shovel 2 hrs.@7.00 14 00
					Trucking 1 hr. @.75 75
					44 55

DATE _____

TOWN OF LEXINGTON — BOARD OF PUBLIC WORKS
WATER DIVISION

Sketch of Service Here

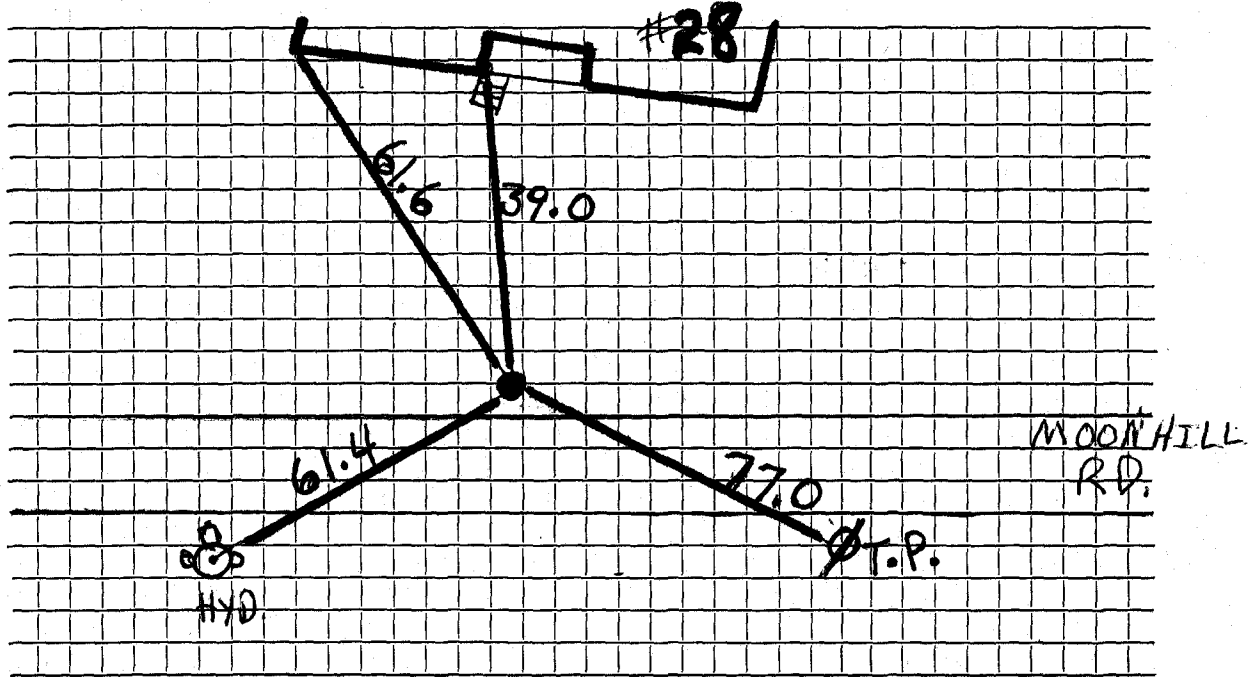

Connection made in Street. Work completed

Remarks:

.....
.....