

Name Stanley Phalen

Service No. 195

Address 29 Moon Hill Road

3492

Lexington, Mass.

Location 29 Moon Hill Road

Kind of Pipe

Size

Size of Main

~~XXXXXX~~ New Service

Com. 12-31-49

Location

Date	Material	Amount	Total	Date	Amount
Oct. 10, '49	Labor	28 80	28 80	Sept 20 '49	200 00
	10% Overhead		2 88	Dec 31 '49	120 76
	160' - 1" Copper Tubing @.28		44 80		129 24
	1 - 1" C x 1" I.W.H. S&W		5 60	Oct. 10, '49	5 00
	2 - 1" C x 1" C Union (3pts)		3 66	20' 1 - " Copper Tubing @.28	5 60
	1 - 1" x 3/4" Bushing		40	1 - 1" C Corp-cock	4 62
	Town Shovel 8 1/2 hrs. @ 3.00		25 50	1 - 1" C x 1" C Curb-cock	5 60
	Truck #19 2 hrs. @ 3.00		6 00	1 - Box & Rod	3 75
	Trailer 2 hrs. @ 3.00		6 00	1 - 3/4" Offset Tail Piece	37
	Rockwool 1/4 bags @ 1.40		5 60	1 - 3/4" Straight Tail Piece	37
			129 24	Rockwood 1 bag	1 40
				Town Shovel 1 hr. @ 3.00	3 00
	Labor			Trucking 1 hr. @.75	75
					30 46

DATE \_\_\_\_\_

TOWN OF LEXINGTON - BOARD OF PUBLIC WORKS

**WATER DIVISION**

The undersigned applies for a supply of water at No..... St. and hereby agrees to comply with the rules and regulations as now, or at any future time, established by the Board of Selectmen.

Am't of Estimate \$.....

Owner .....


Am't Paid \$.....

Address .....

Builder .....

Sketch of Service Here

FOR # 29 MOON HILL RD.

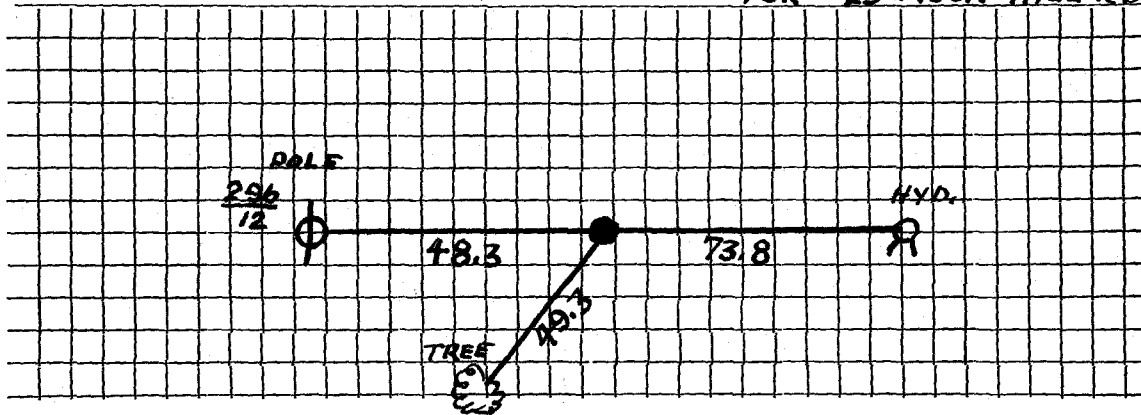

Connection made in ..... Street.

Work completed .....19

Remarks: