

WATER SERVICE RECORD

Name Stanley Phalen

Service No. 197

Address 31 Moon Hill Road

6358

Location Lexington, Mass.

~~Repair Renewal~~ - New Service

Com2 12-26-50


Date	Material	Amount	Total	Date	Amount
Aug. 17, '50	Labor	7 50	7 50	July 29, '50	150 00
	10% Overhead		75		7 00
	183' - 1" Copper Tubing @.284		51 97		No Charge
	1 - 1"C x 1/2" I.W.H. S&W		4 48	Aug. 18, '50	Labor
	2 - 1"C x 1"C Unions (3pts)		3 66		12 70
	1 - 1" x 3/4" Bushing		49		15' - 1" Copper Tubing @.284
	Littlefield Shovel 9 hrs. @7.00		63 00		4 26
	Trucking 1 hr. @.75		75		1 - 1"C Corp-cock
	Patching 10 x 3		10 00		4 62
			142 60		1 - 1"C x 1"C Curb-cock
					5 60
					1 - Box & Rod
					3 35
					1 - 3/4" Offset Tail Piece
					42
					1 - 3/4" Straight Tail Piece
					42
					Littlefield Shovel 3 hrs. @ 7.00
					21 00
					Trucking 1 hr. @.75
					75
					53 12

DATE _____

TOWN OF LEXINGTON — BOARD OF PUBLIC WORKS

WATER DIVISION

Sketch of Service Here

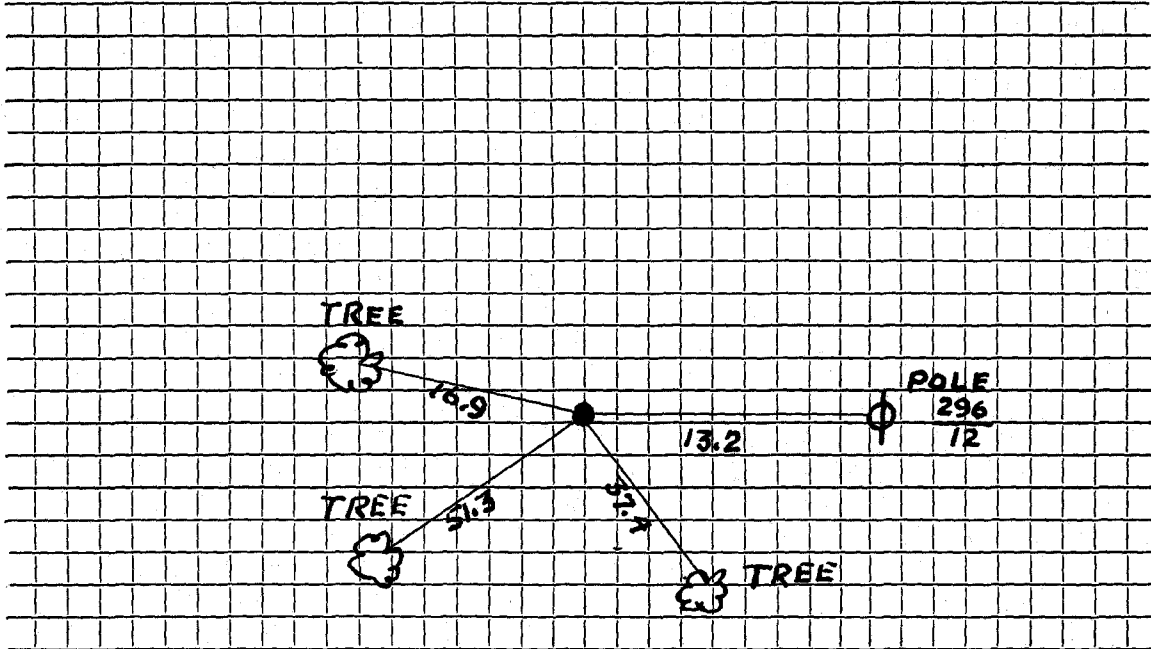

Connection made in Street. Work completed

Remarks:
.....
.....