

Name **Custance Brothers**Service No. **#4440** 34Address **32 Moon Hill Road****Lexington, Mass.**Location **32 Moon Hill Road**

Kind of Pipe

Size

Size of Main

~~XXXXXXXXXX~~ **New Service**Com. **5-2-49**

Location

Date	Material	Amount	Total	Date	Amount
March 22, '49	Labor	9 50	9 50	March 18, '49	50 00
	10% Overhead		95	May 1, '49	5 31
	60' - 3/4" Copper Tubing @.27	16 20			44 62
	1 - 3/4" C x 1/2" I.W.H. S & W	3 29		March 22, '49	10 00
	Littlefield Shovel 2 hrs. @7.00	14 00		March 23, '49	9 43
	Trucking 1 hr. @.75		75	28' - 3/4" Copper Tubing @.27	7 56
			44 69	1 - 3/4" C Corp-cock	3 15
				1 - 3/4" C x 3/4" C Curb-cock	3 85
				1 - Box & Red	3 95
				1 - 1/2" Straight Tail Piece	37
				1 - 1/2" Offset Tail Piece	37
				1 - 1/2" Straight Tail Piece	37
	Labor			Littlefield Shovel 5 hrs. @7.00	35 00
				Trucking 1 hr. @.75	75
					74 80

TOWN OF LEXINGTON - BOARD OF PUBLIC WORKS

WATER DIVISION

The undersigned applies for a supply of water at No..... St. and hereby agrees to comply with the rules and regulations as now, or at any future time, established by the Board of Selectmen.

Am't of Estimate \$.....

Owner


Am't Paid \$.....

Address

Builder

.....

Sketch of Service Here

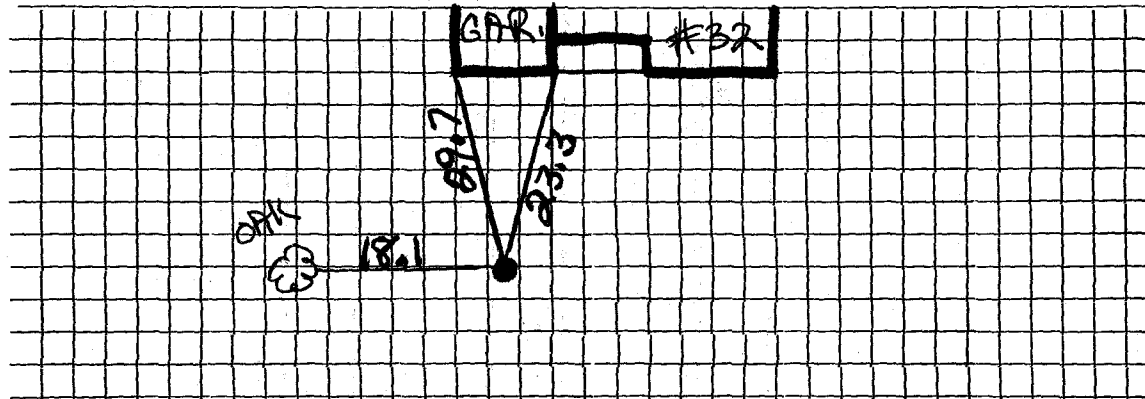

Connection made in Street.

Work completed19

Remarks: