

Name Arthur Kip

Service No. 117
117A

Address 33 Moon Hill Road

Lexington, Mass.

Location 33 Moon Hill Road

Kind of Pipe

Size

Size of Main

~~REPAIR WORK~~ New Service Com. September 26, 1949

Location

Date	Material	Amount	Total	Date	Amount
Jul. 13, '49	Labor	29 17			
18	"	<u>30 35</u>	59 52	June '49	125 00
	10% Overhead		5 95	Oct 24 '49	8 36
	161' - 1" Copper Tubing @.302		48 62	Oct 24 '49	<u>183 36</u>
	1 - 1" C x 1" I.W.H. S&W		3 29	Jul. 18, '49	16 00
	2 - 1" C x 1" C Unions		3 66	7' - 1" Copper Tubing @.302	2 11
	1 - 1" x 3/4" Bushing		49	1 - 1" C Corp-cock	4 62
	Dynamite 17 lbs. @.215		3 66	1 - 1" C x 1" C Curb-cock	5 50
	Exploders 24 @ .117		2 81	1 - Box & Rod	3 95
	Compressor 9 hrs. @ 1.75		15 75	1 - 3/4" Offset Tail Piece	37
	Littlefield Shovel 4 hrs. @ 7.00		28 00	1 - 3/4" Straight Tail Piece	37
	Rockwood 2 bags @ 1.40		2 80	Littlefield Shovel 1 hr. @ 7.00	7 00
	Trucking 2 hrs. @ 3.00		6 00	Trucking 1 hr. @ .75	75
	Labor Trucking 1 hr. @ .75		75		<u>40 67</u>
	Patching 3 x 2		2 00		
	Bill sent 10-6-49		183 30		

DATE _____

TOWN OF LEXINGTON - BOARD OF PUBLIC WORKS

WATER DIVISION

The undersigned applies for a supply of water at No..... St. and hereby agrees to comply with the rules and regulations as now, or at any future time, established by the Board of Selectmen.

Am't of Estimate \$.....

Owner


Am't Paid \$.....

Address

Builder

.....

Sketch of Service Here

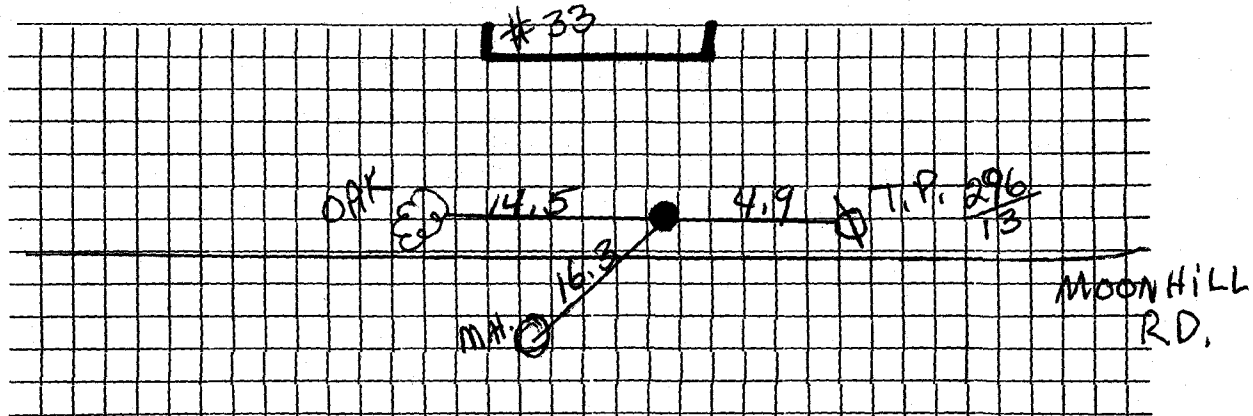

Connection made in Street.

Work completed19

Remarks: