

Name Wallace Howell

Service No. 125

Address 35 Moon Hill Road

Lexington, Mass.

Location 35 Moon Hill Road

Kind of Pipe

Size

Size of Main

Repair—Renewal—New Service

Location

Date	Material	Amount	Total	Date	Location	Amount
Aug. 30, '48	Labor	4 20	4 20	July 29 '75	Deposited	50 00
	10% Overhead		42	Oct. 30 '75	Paid	13 34
	160' - 1" Copper Tubing @.31	49 60			Non-Charge	63 34
	1 - 1" C x 3/4" I.W.H. S & W	3 15		Aug. 13, '48	Labor	2 10
	3 - 1" & x 1" C Unions (3pts)	5 22		14	"	11 78
	Trucking 1 hr. @.75	75		9' - 1" Copper tubing @.31		2 79
			63 34	1 - 1" C Corp-cock		3 96
				1 - 1" C x 1" C Curb-cock		4 80
				1 - Box & Rod		3 55
				Littlefield Shovel 2 hrs. @7.00		14 00
				1 - 3/4" Offset Tail Piece		30
				1 - 3/4" Straight Tail Piece		30
				Trucking 1 hr. @.75		75
						44 33

Bill and 11-25-75

trench dug by owner.

Labor

Hadley Press, Inc., Lexington

TOWN OF LEXINGTON—BOARD OF PUBLIC WORKS

WATER DIVISION

The undersigned applies for a supply of water at No. _____ St. and hereby agrees to comply with the rules and regulations as now, or at any future time, established by the Board of Selectmen.

Am't. of Estimate \$ _____


Owner _____

Am't. Paid \$ _____

Address _____

Builder _____

Sketch of Service Here

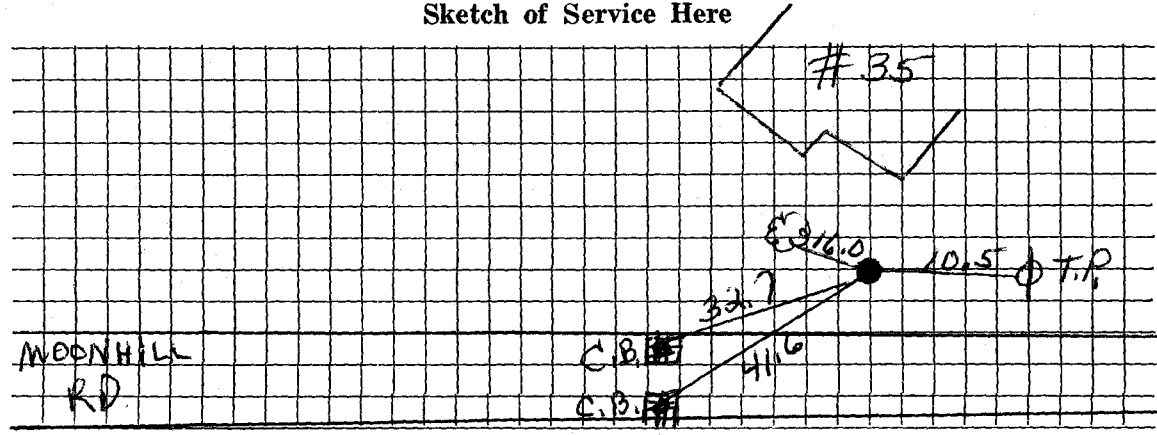

Connection made in _____ Street. Work completed _____ 19

Remarks: