

WATER SERVICE RECORD

Name R. S. Moorehouse

Service No. 169

Address 37 Moon Hill Road

# 1755

Location Lexington, Mass

~~Repair - Renewal~~ - New Service

Com. 12-26-50


Date	Material	Amount	Total	Date	Amount
Aug. 2, '50	Labor	2 60	2 60	July 21, 50 Deposited	60 00
	10% Overhead		26		1 22
	112' - 1" Copper Tubing @.284		31 81		No Charge
	1 - 1"C x 3/4" I.W.H. S&W		4 48	Aug. 2, '50 Labor	5 84
	2 - 1"C x 1"C Unions (3pts)		3 66	23' - 1" Copper Tubing @.284	6 53
	Trucking 1 hr. @.75		75	1 - 1" C Corp-cock	4 62
	Patching 15 x 3		15 00	1 - 1"C x 1"C Curb-cock	5 60
			58 56	1 - Box & Rod	3 35
				2 - 3/4" Straight Tail Pieces	76
				Littlefield Shovel 3 1/2 hrs. @7.00	24 50
				Trucking 1 hr. @.75	75
					51 95

DATE \_\_\_\_\_

# TOWN OF LEXINGTON — BOARD OF PUBLIC WORKS

## WATER DIVISION

Sketch of Service Here

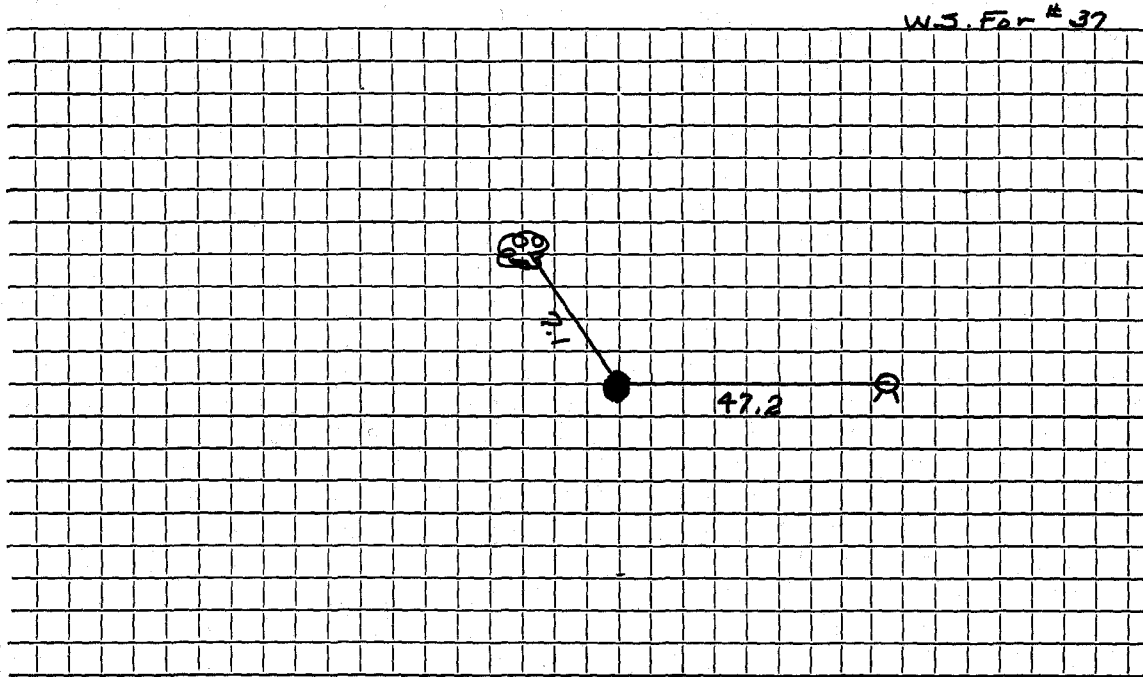

Connection made in ..... Street. Work completed .....

Remarks: .....

.....  
.....