

WATER SERVICE RECORD

Name George H. Todd

Service No. 94

Address 39 Moon Hill Rd.

Location Lexington, Mass.

~~Water~~ - New Service

*Cam 9-24-51*


Date	Material	Amount	Total	Date	Amount
6/21/51	Labor	2 98	2 98	5-18-51	Deposited 70 00
	10% overhead		30	9-24-51	Refunded 17 80
	75' -3/4" copper tubing @ .326	24 45			No Charge 52 20
	1 -3/4" C x 1/2 I.W.H. stop&waste		4 00	6/21/51	Labor 16 34
	1 -3/4" C x 3/4" C. union (3pt.)	1 72			36' -3/4" copper tubing @ .326 11 73
	1 hr. trucking		75		1 -3/4" C. corp-cock 4 33
	patching 18 x 3		18 00		1 - 3/4" C. x 3/4" C. curb-cock 4 67
			52 20		1 - box & rod 4 68
					4 bags rockwool @ 1.38 5 52
					1 -1/2 offset tail piece 50
					1 - 1/2 straight tail piece 50
					6 hrs. littlefield shovel @ 7. 42 00
					1 hr. trucking 75
					91 02

DATE \_\_\_\_\_

# TOWN OF LEXINGTON — BOARD OF PUBLIC WORKS

## WATER DIVISION

Sketch of Service Here

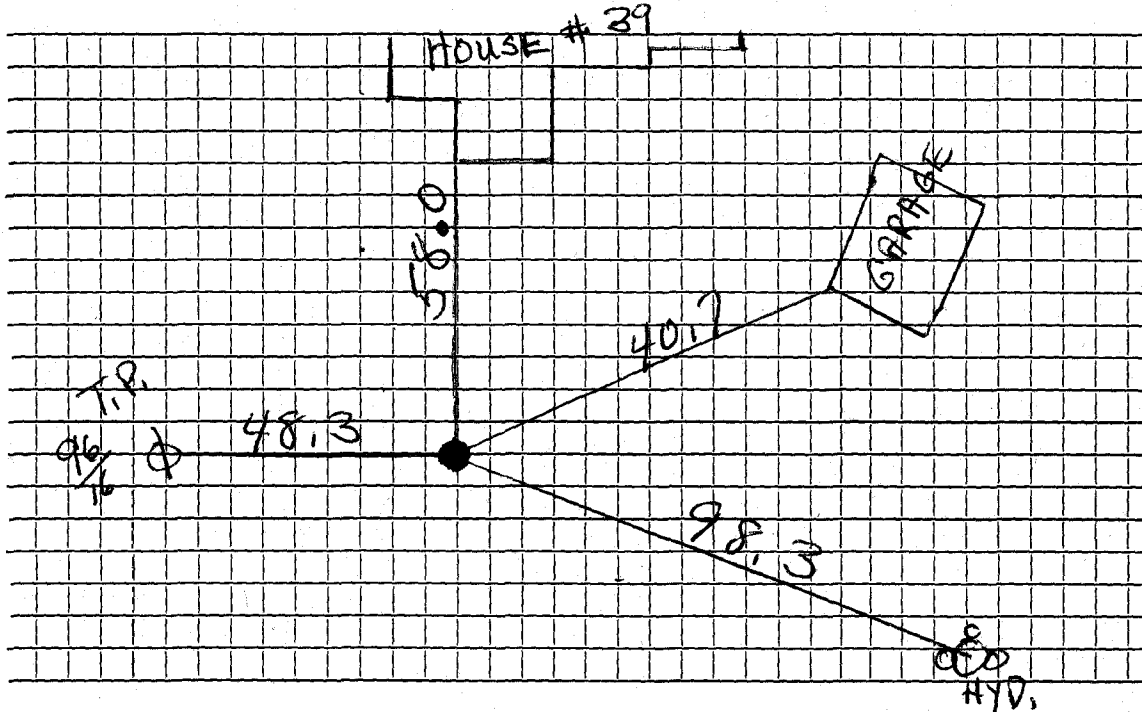

Connection made in ..... Street. Work completed .....

Remarks: .....

.....  
.....