




DATE \_\_\_\_\_

TOWN OF LEXINGTON — BOARD OF PUBLIC WORKS

WATER DIVISION

Sketch of Service Here

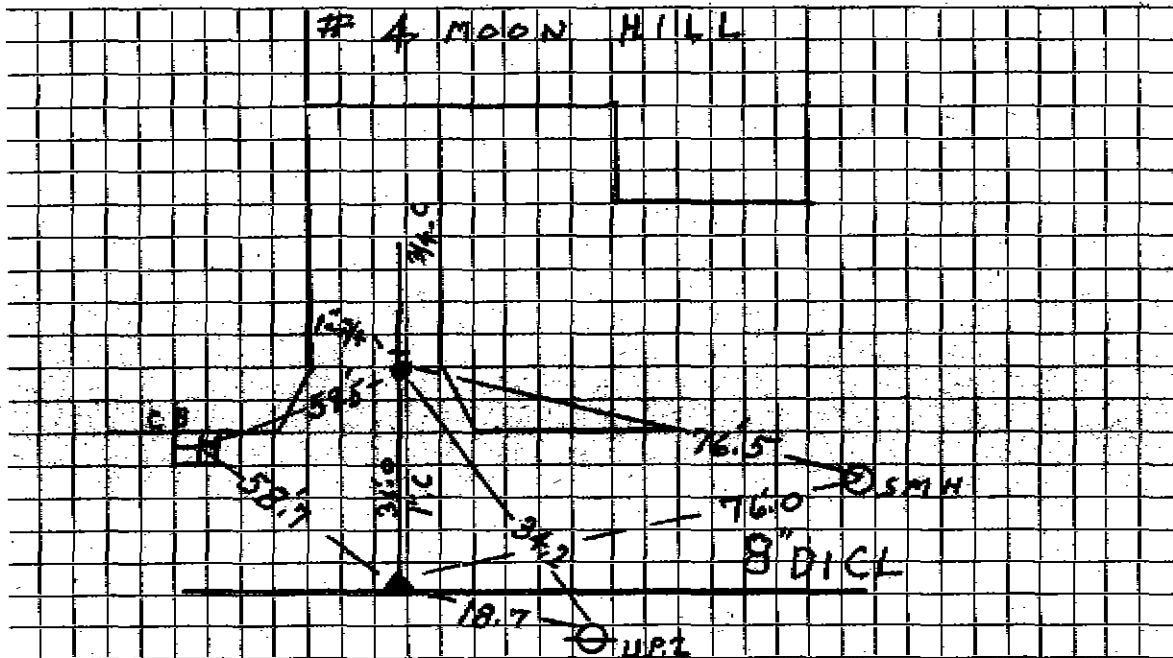

Connection made in ..... Street. Work completed 6/8/09 P.A.O. C.V.P. ....

Remarks: .....  
.....  
.....