

Name Edward Diehl

(1949) Service No. 269

Address 40 Moon Hill Road

Lexington, Mass.

Location 40 Moon Hill Road

Kind of Pipe

Size

Size of Main

Remarks: New Service

Con. 5/22/50

Location

Date	Material	Amount	Total	Date	Amount
Jan. 27, '50	Labor	5 10	5 10	Dec. 29 '49	80 00
	10% Overhead		51	May 20 '50	17 26
	170' - 1" Copper Tubing @.28	47 60		No Charge	62 74
	1 - 1" C x 1" I.W.H. S&W	3 29	1-24-50	Labor	7 40
	3 - 1" C x 1" C Union (3pts) 1.83	5 49	1-25-50	"	42 40
	Trucking 1 hr. @.75	75	1-27-50		5 75
			62 74	35' - 1" Copper Tubing @.28	9 80
				Rockwool - 1 bag	1 40
				Dynamite 30 lbs. @.22	6 60
				Caps 25 @ .12	3 00
				#36 Compressor 4 hrs. @ 2.75	11 00
				#37 Compressor 8 hrs. @ 1.75	14 00
	Labor			Littlefield Shovel 1 1/2 hrs. @ 7.00	31 50
				Trucking 1 hr. @.75	75
					133 20

TOWN OF LEXINGTON - BOARD OF PUBLIC WORKS

WATER DIVISION

The undersigned applies for a supply of water at No..... St. and hereby agrees to comply with the rules and regulations as now, or at any future time, established by the Board of Selectmen.

Am't of Estimate \$.....


Owner

Am't Paid \$.....

Address

Builder

Sketch of Service Here

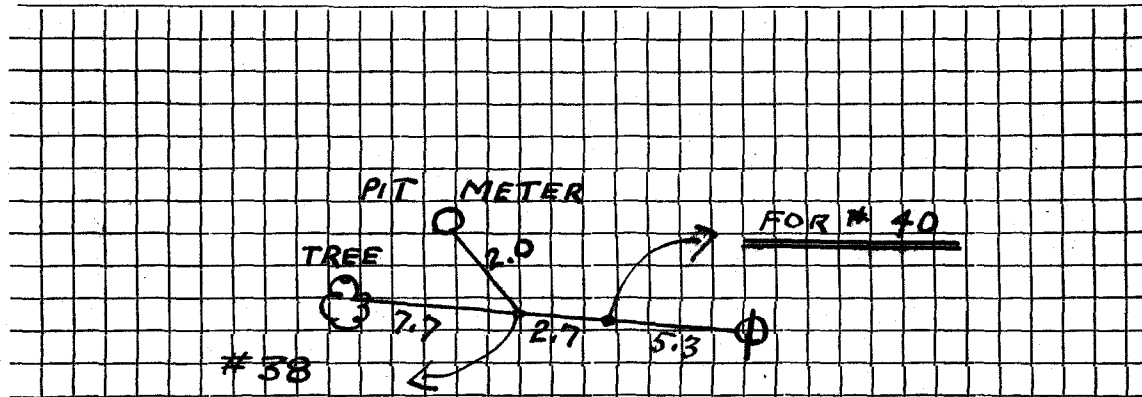

Connection made in Street.

Work completed19

Remarks: