




DATE \_\_\_\_\_

TOWN OF LEXINGTON — BOARD OF PUBLIC WORKS

WATER DIVISION

Sketch of Service Here

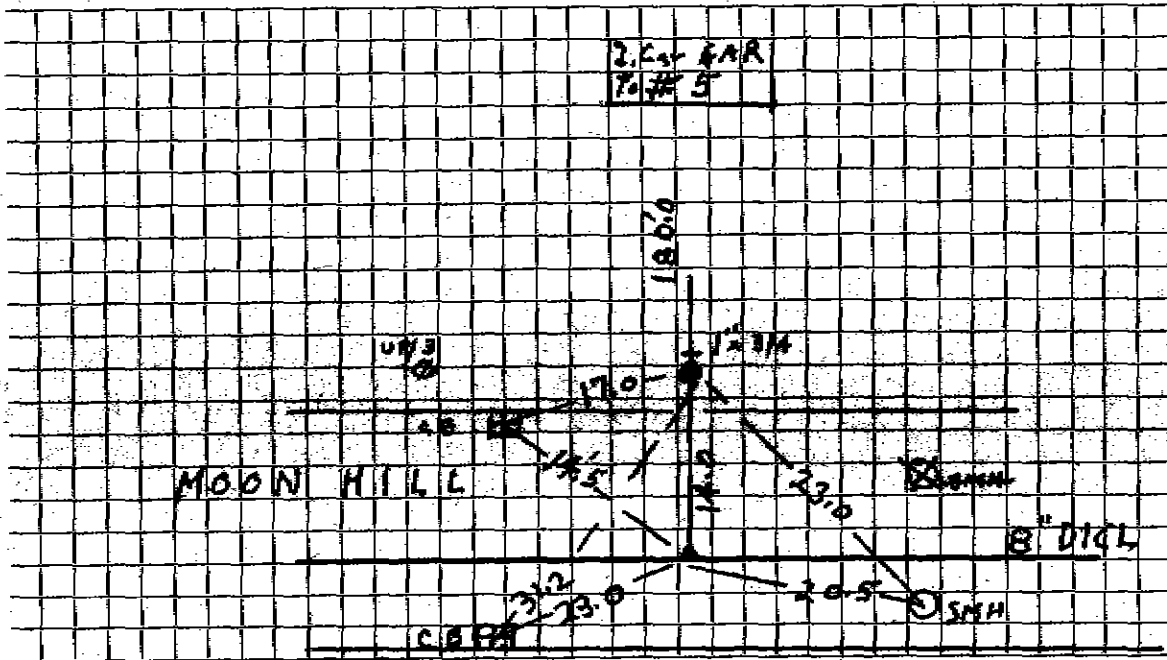

Connection made in ..... Street.

Work completed 6/8/09 P.A.O. Corp.

Remarks: .....

.....

.....