

WATER SERVICE RECORD

Name **Moore Construction Company**

Service No. **1**

Address **6 Moon Hill Road**

Location **Lexington, Mass.**

~~Repair~~ ~~Renewal~~ **New Service**

Com. **2-19-51**


Date	Material	Amount	Total	Date	Amount
1-12-51	Labor	2 70	2 70	Jan 3 51	65 00
	10% Overhead		27		6
	105' - 3/4" Copper Tubing @ .34	35 70			60 15
	1 - 3/4" C x 1/2" I.W.H. S&W	4 00		No Charge	
	1 - 3/4" C x 3/4" C Union (3pts)	1 72		1-12-51 Labor	10 97
	Trucking 1 hr. @ .75	75		24' - 3/4" Copper Tubing @ .34	8 16
	Patching 15 x 3	15 00		1 - 3/4" C Corp-cock	4 33
4-2-74	Renewal		60 14	1 - 3/4" C x 3/4" C Curb-cock	4 67
	64' 3/4" Copper			1 - Box & Rod	3 90
	2 3/4" - 2 Part Unions			1 - 1/2" Offset Tail Piece	50
	1 3/4" Wheel Valve			1 - 1/2" Straight Tail Piece	50
	1 3/4" X 1/2" Bushing			Littlefield Shovel 4 hrs. @ 7.00	28 00
				Trucking 1 hr. @ .75	75
					61 78

DATE _____

TOWN OF LEXINGTON — BOARD OF PUBLIC WORKS

WATER DIVISION

Sketch of Service Here

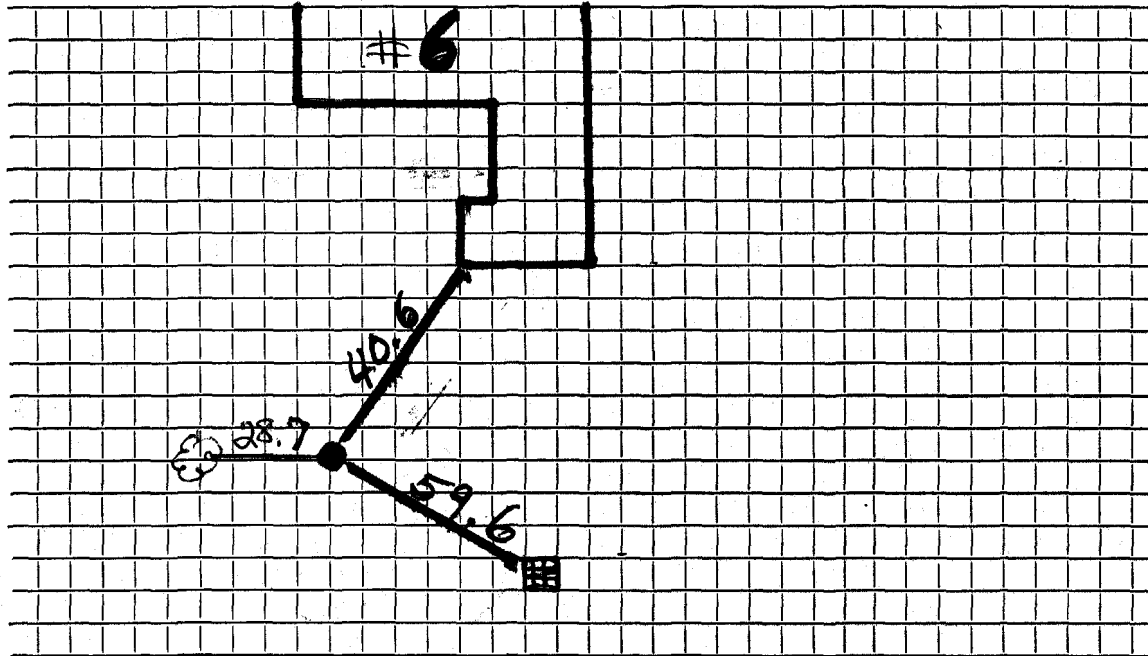

Connection made in Street. Work completed

Remarks:
.....
.....