




DATE \_\_\_\_\_

TOWN OF LEXINGTON — BOARD OF PUBLIC WORKS

**WATER DIVISION**

Sketch of Service Here

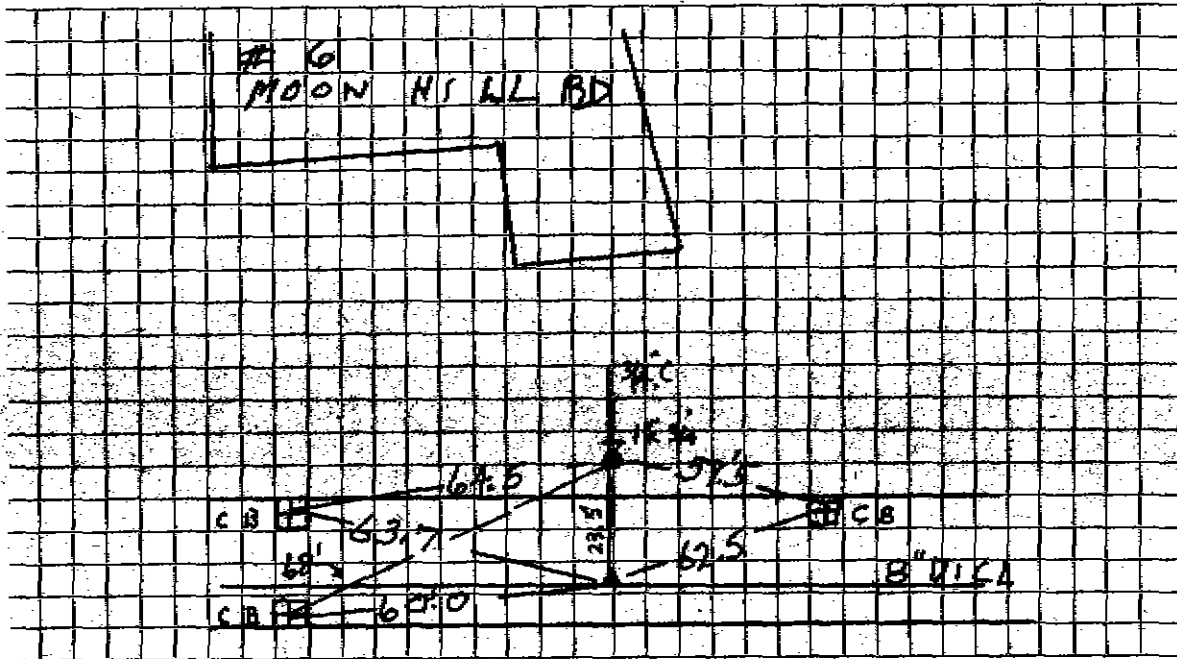

Connection made in ..... Street.

Work completed 6/9/09 PAO, C.O.R.P......

Remarks: .....

.....

.....