

WATER SERVICE RECORD

Name

Service No.

Address

2 Moreland Ave

Location

Lot 77

Repair—Renewal—New Service


Date		Material	Amount		Total	Date		Amount
1/11/51	32'	3/4 Copper				5/09/27	PAO Corp	
	1	3/4 x 3/4 3 part Union					1" Copper	
		3/4 x 3/2 SFW					1" Corp	Joint 4"
							1" Curb Stop	
							1 1/2 x 3/4 Red	
							buffle box	

DATE _____

TOWN OF LEXINGTON — BOARD OF PUBLIC WORKS

WATER DIVISION

Sketch of Service Here

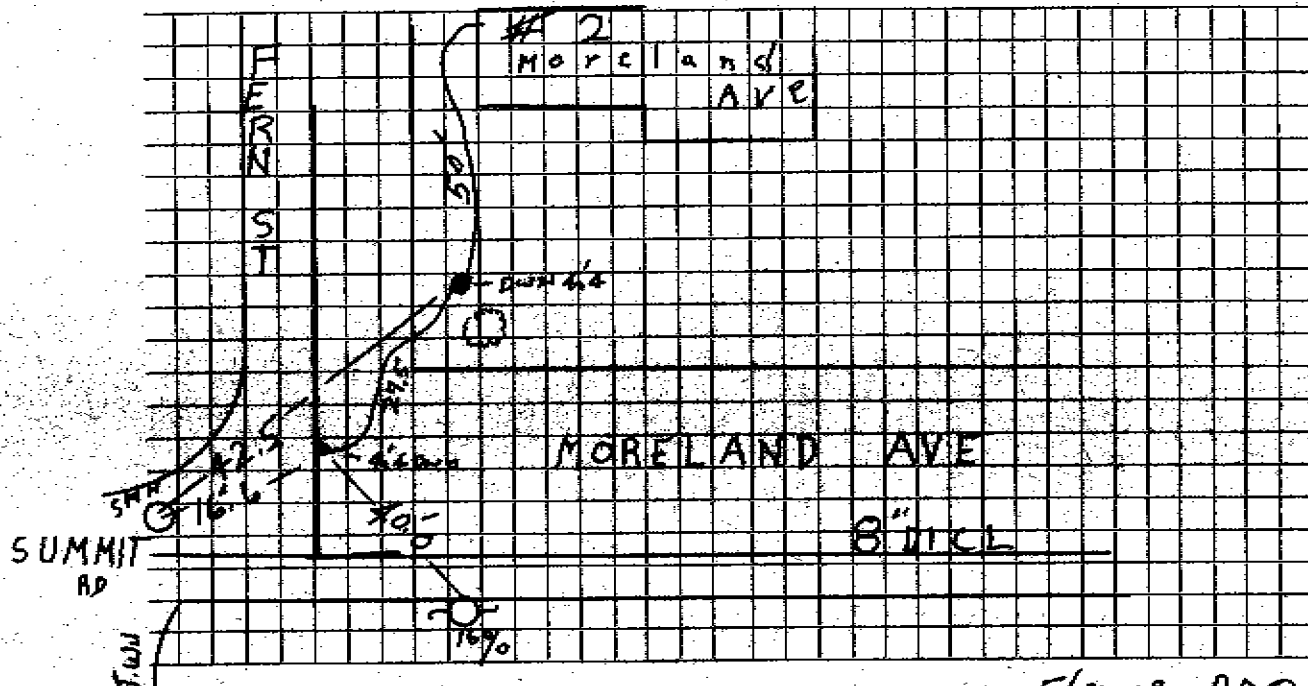

Connection made in Street. Work completed 5/2009 PAD CORP

Remarks:
.....
.....