


DATE _____

TOWN OF LEXINGTON — BOARD OF PUBLIC WORKS

WATER DIVISION

Sketch of Service Here

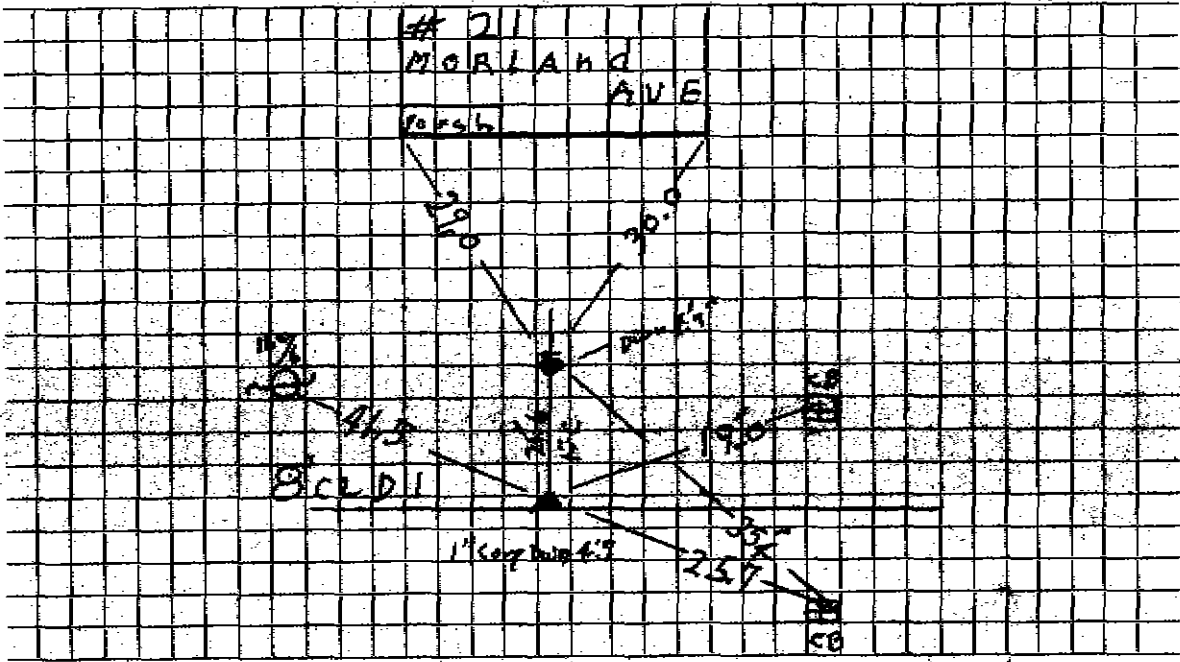

Connection made in Morland Ave Street. Work completed 5/29/09 P.A.O.

Remarks: 1" from curb to house