


DATE

TOWN OF LEXINGTON — BOARD OF PUBLIC WORKS

WATER DIVISION

Sketch of Service Here

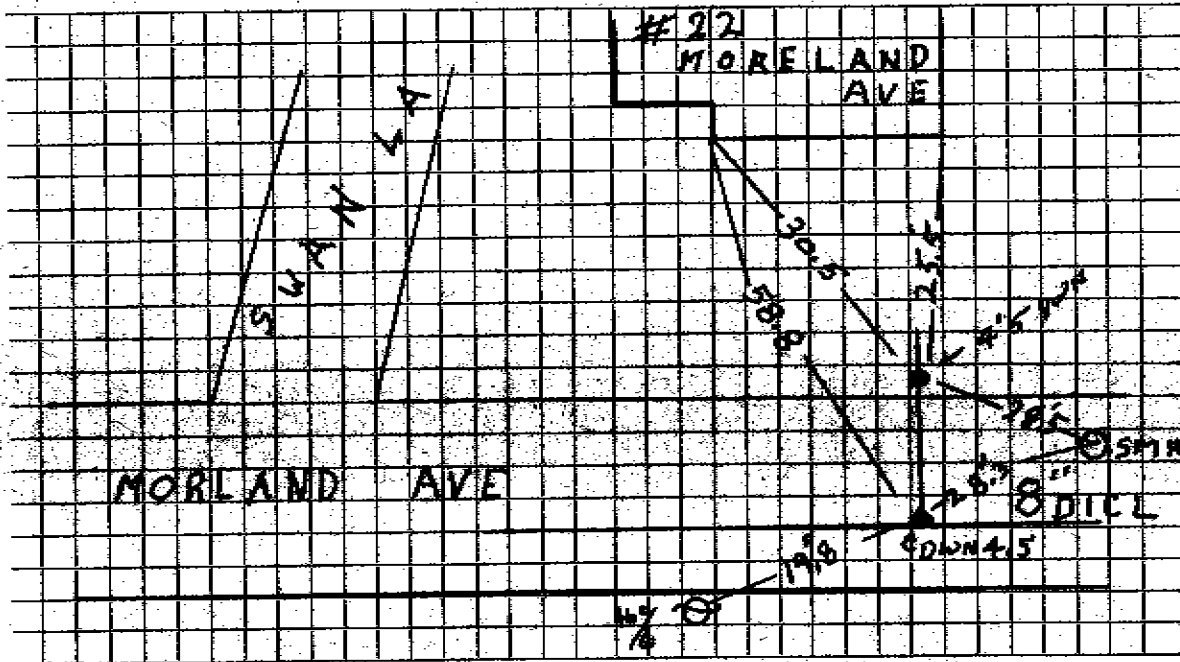

Connection made in Morland Ave Street.

Work completed 5/29/09 PAO Corp

Remarks: