


DATE _____

TOWN OF LEXINGTON — BOARD OF PUBLIC WORKS

WATER DIVISION

Sketch of Service Here

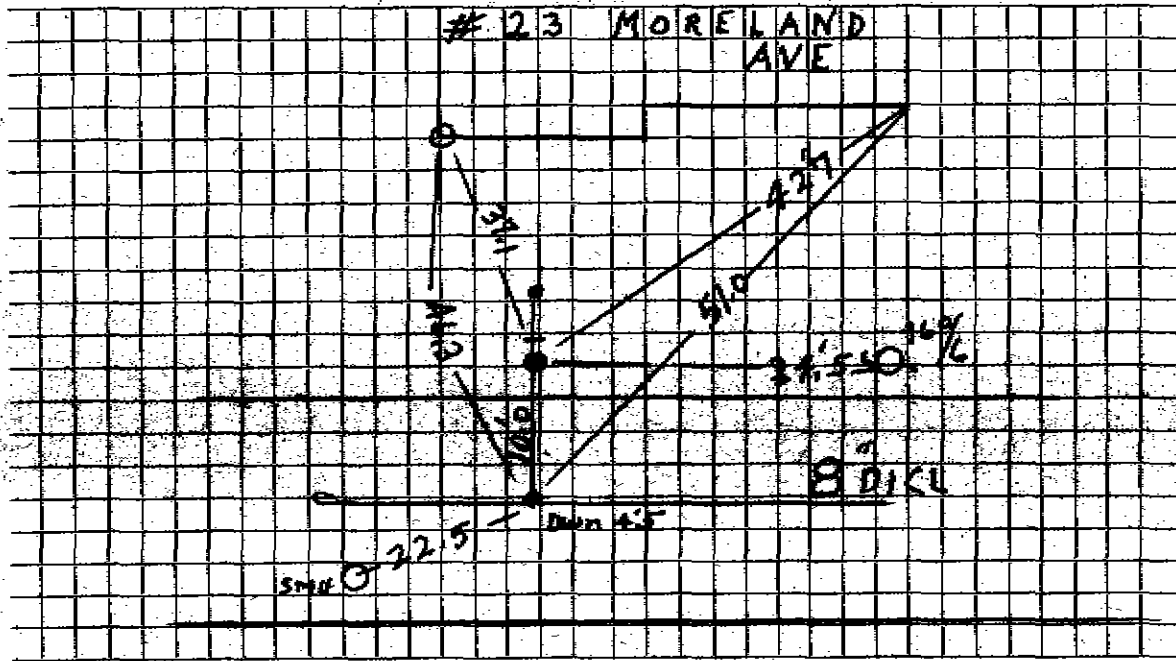

Connection made in _____ Street. Work completed 5/29/09 P.A.O.

Remarks: Curb 5 Tap Down 3'.0, (old curb left in place - planter status)