




DATE \_\_\_\_\_

TOWN OF LEXINGTON — BOARD OF PUBLIC WORKS

WATER DIVISION

Sketch of Service Here

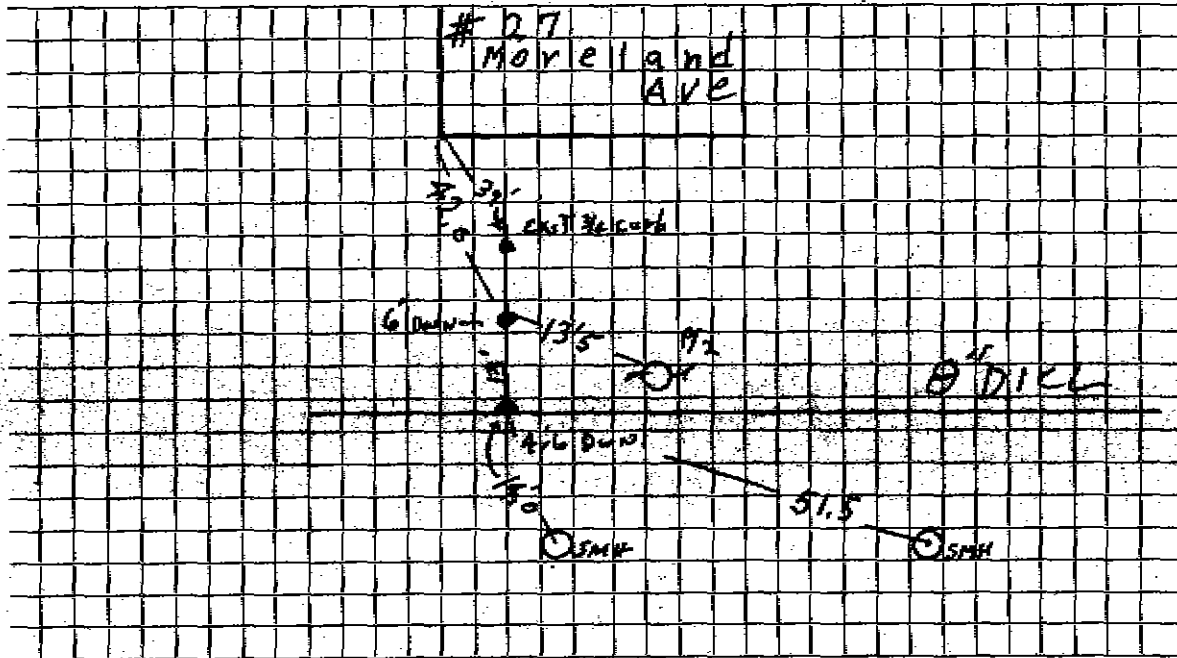

Connection made in ..... Street. Work completed 5/29/09 PRO

Remarks: E.K.I. 3/4" C.u.v.b. 1.95T. 1.25 Place