


DATE _____

TOWN OF LEXINGTON — BOARD OF PUBLIC WORKS

WATER DIVISION

Sketch of Service Here

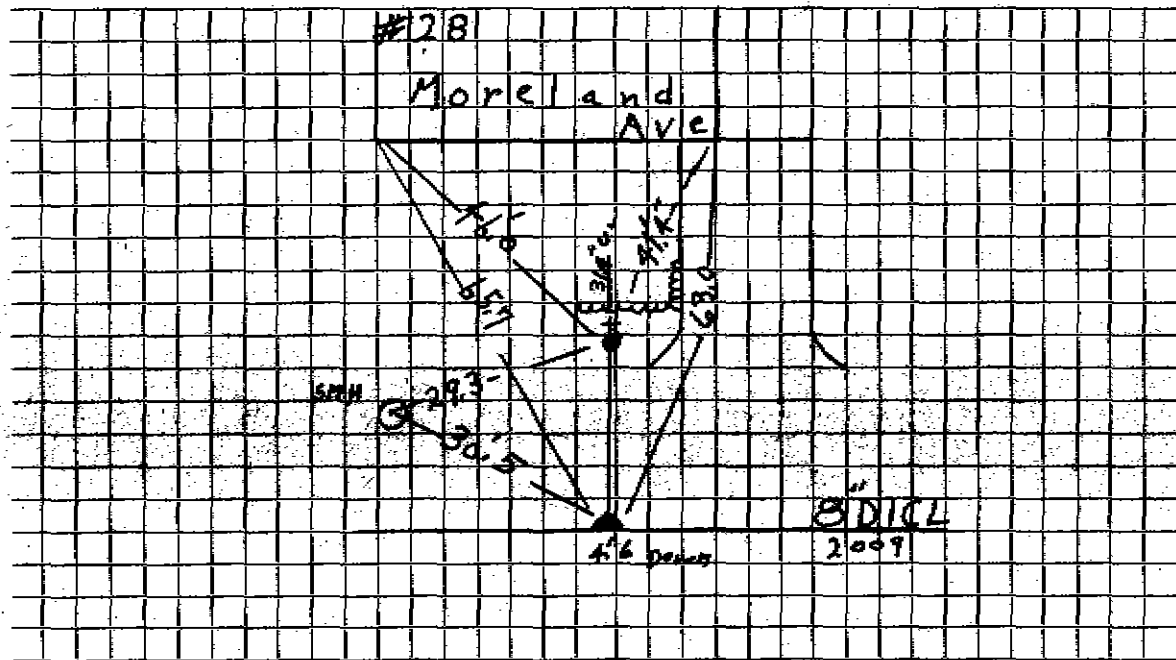

Connection made in Street. Work completed 5/29/09 PAE-CORP.

Remarks: Repair Sewer - Water + Sewer 12" Apert

..... Curb depth 4'