


DATE _____

TOWN OF LEXINGTON — BOARD OF PUBLIC WORKS

WATER DIVISION

Sketch of Service Here

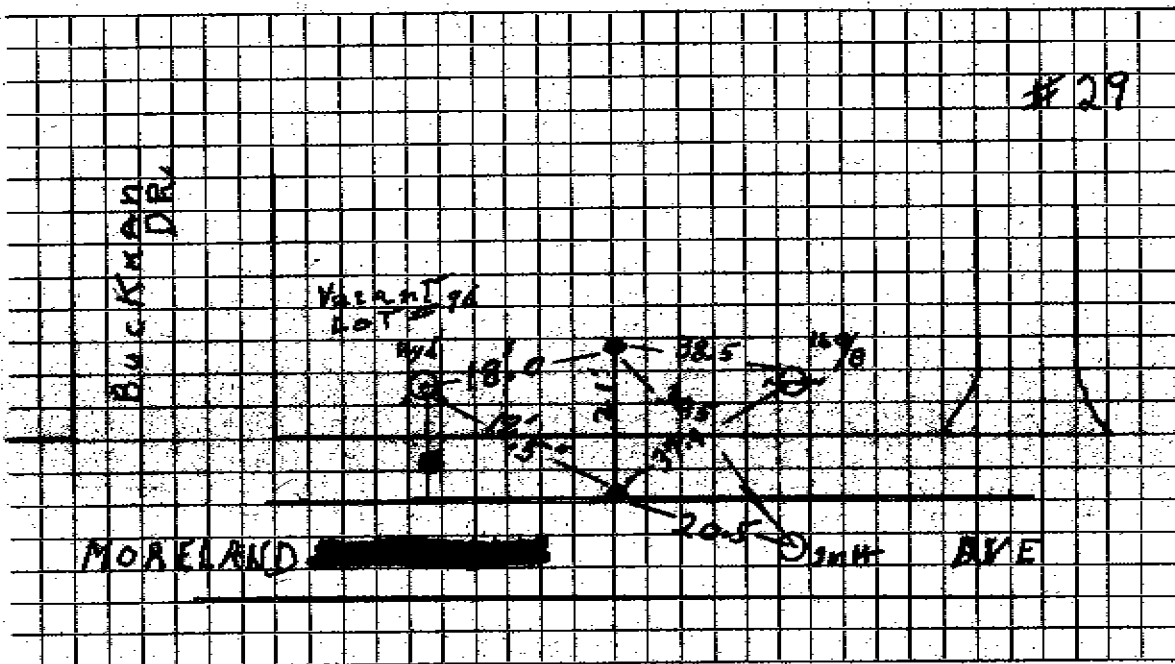

Connection made in Moreland Ave Street.

Work completed 4/1/09 P.A.O.

Remarks: Will be house #31?