

WATER SERVICE RECORD

Name

Service No.

Address # 32 - Mansland Ave

Location Vac Lot was Green Hook Rd # 30

LOT 5

Repair—Renewal—New Service


Date		Material	Amount	Total	Date	PAO Corp	Amount
					6/1/09	30'	
						1" copper	
						1" COP	100.45
						1" Cook ST pipe	4.8
						1" gal Union	
						buffle box	

DATE \_\_\_\_\_

TOWN OF LEXINGTON — BOARD OF PUBLIC WORKS

WATER DIVISION

Sketch of Service Here

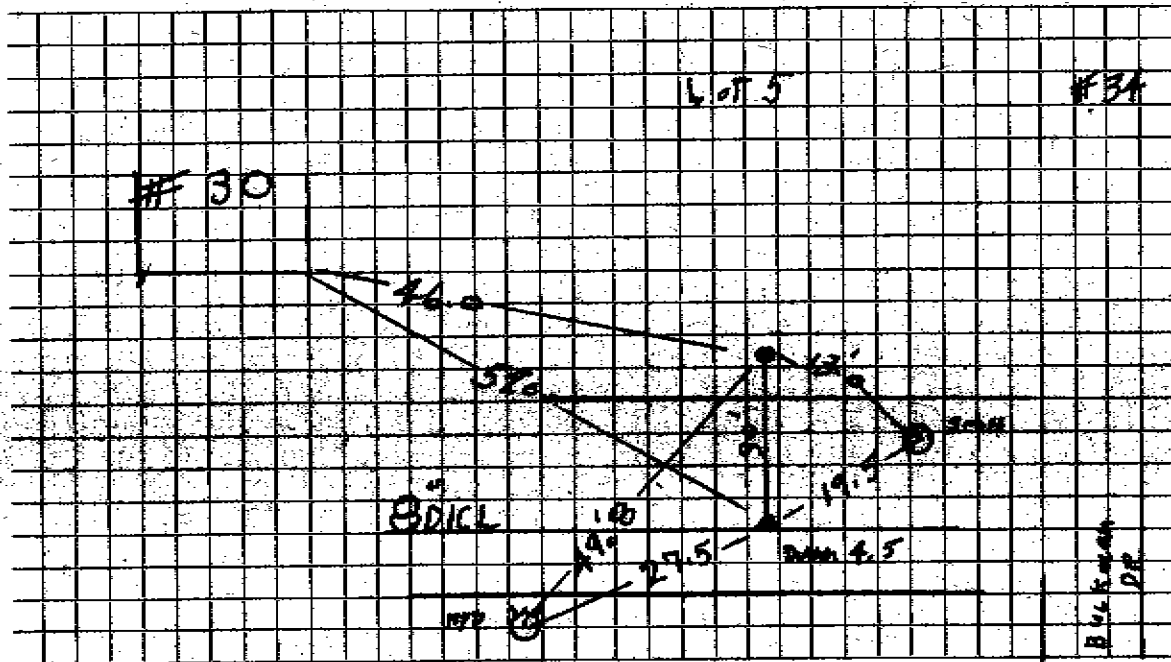

Connection made in Moresland Ave. Street. Work completed 6/1/09 PMS

Remarks: This service went to Green house for NO 30