

WATER SERVICE RECORD

Name

Service No.

Address #33 Moreland Ave

Location Lot 11

Repair—Renewal—New Service


Date	Material	Amount	Total	Date		Amount
					NON CHARGE	
				8-26-60	Labor	1 94
					18' 3/4" Copper tubing	6 60
					1 3/4" CCurb Cock	6 03
					1 3/4" CCorp Cock	4 64
					1 Box & Rod	<u>5 00</u>
						24 21

DATE \_\_\_\_\_

# TOWN OF LEXINGTON — BOARD OF PUBLIC WORKS

## WATER DIVISION

Sketch of Service Here

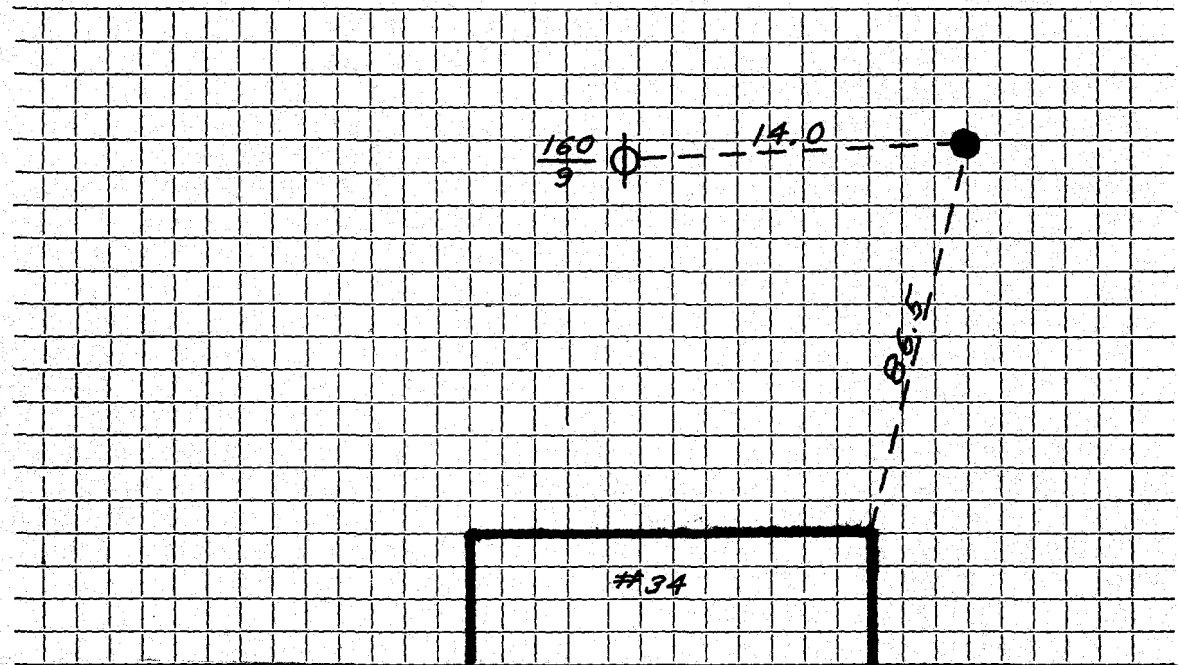

Connection made in ..... Street. Work completed .....

Remarks: .....  
.....  
.....