




DATE \_\_\_\_\_

TOWN OF LEXINGTON — BOARD OF PUBLIC WORKS

WATER DIVISION

Sketch of Service Here

bot 6

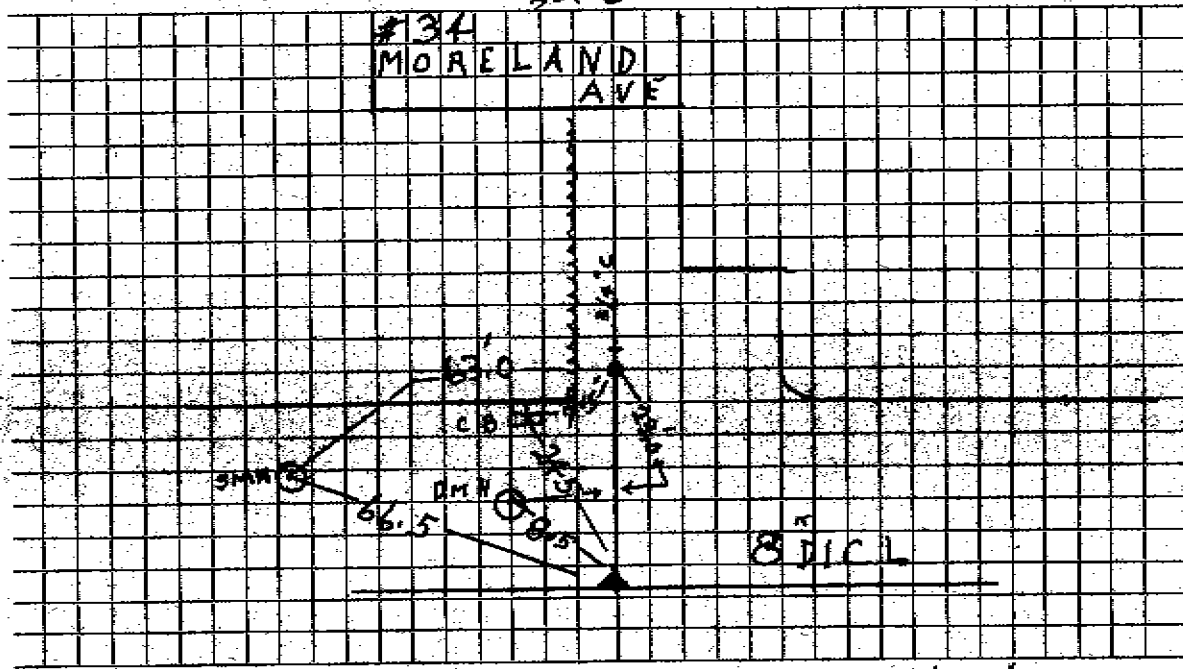

Connection made in..... Street. Work completed 6/12/09 PRO-CORP.

Remarks: 1" Cor. P. - DWJN. 4" 1" Cor. P. - DWJN. 3:7