

## WATER SERVICE RECORD

#5599

Name George D. Lemmler

Service No. 93

Address 35A Moreland Avenue

Location

~~Repair~~ ~~Renewal~~ New Service


Comm 9-25-61

Date	Material	Amount	Total	Date	Amount	
7-12-61	Labor	5.54		7-16-61	Deposit	50 00
	10% O.H.	.55	6.09	9-25-61	Returned	73
43'	3/4" Copper Tubing @.42		18.06			49 27
1	3/4" x 1/2" Comp. Valve		6.17			
1	Curb Box		15.95		NON CHARGE	
1	Hr. Trucking @3.00		3.00	8-24-60	Labor	1 94
			49.27	14'	3/4" Copper tubing	5 13
				1	3/4" CCorp Cock	4 64
				1	3/4" CCurb Cock	6 03
				1	Box & Rod	5 00
						22 74
				7-12-61	1 1/2 Straight tailpiece	.50
					1 1/2 Offset tailpiece	.50
						23.74

TOWN OF LEXINGTON — BOARD OF PUBLIC WORKS

**WATER DIVISION**

Sketch of Service Here

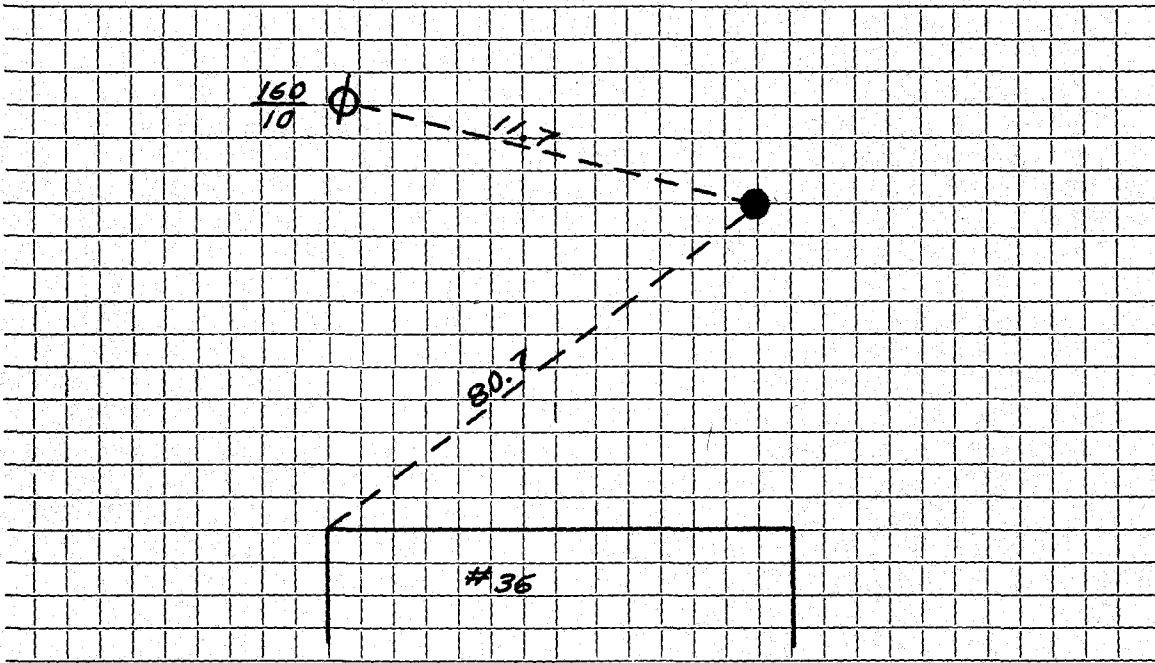

Connection made in ..... Street. Work completed .....

Remarks: .....  
.....  
.....