


DATE _____

TOWN OF LEXINGTON — BOARD OF PUBLIC WORKS

WATER DIVISION

Sketch of Service Here

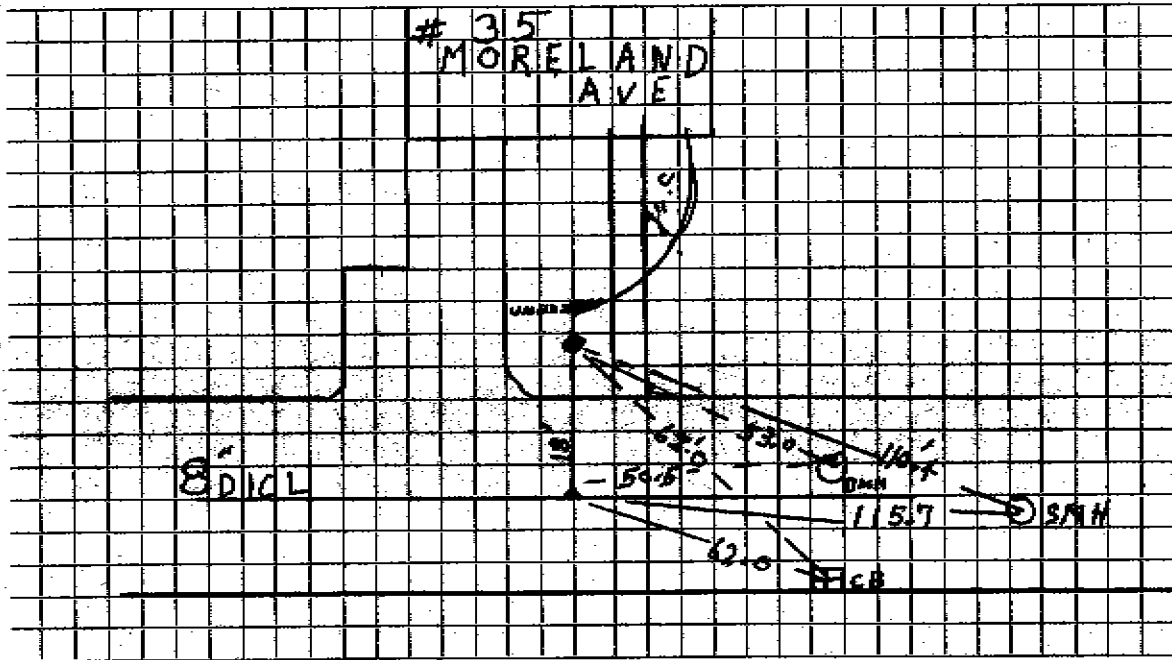

Connection made in _____ Street. Work completed 6/19/09 - PAO

Remarks: PAO. CONTRACTOR EXCAV. FOUND 1" CAP. PIP. TO HOUSE ←