




DATE \_\_\_\_\_

TOWN OF LEXINGTON — BOARD OF PUBLIC WORKS

WATER DIVISION

Sketch of Service Here

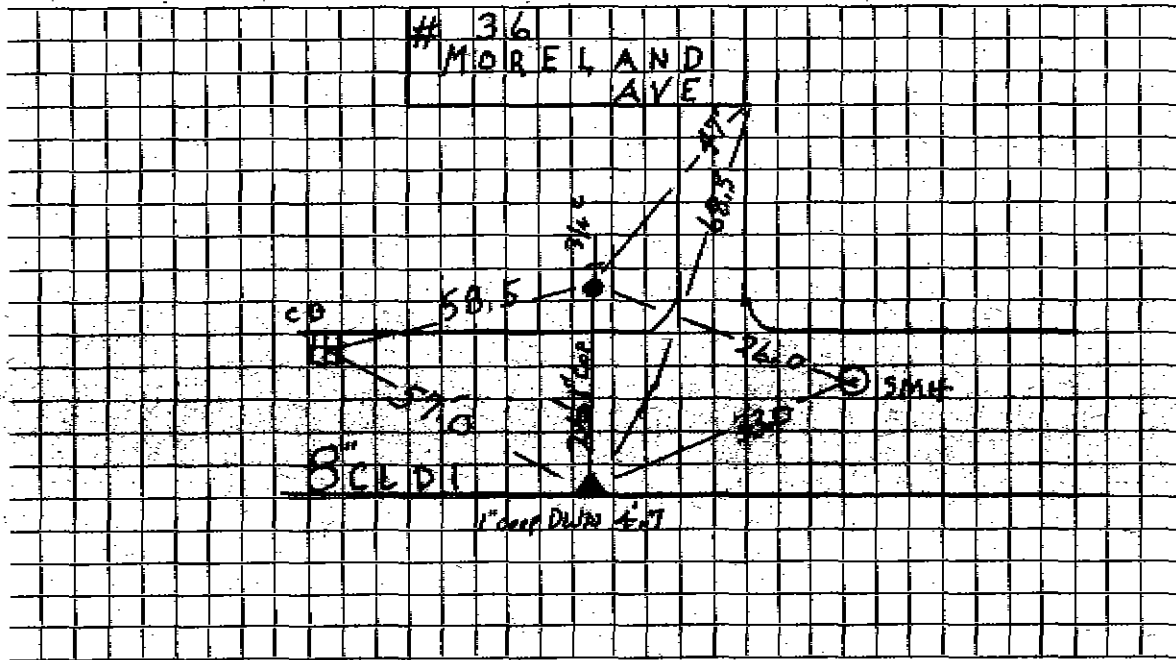

Connection made in ..... Street. Work completed 6/11/09 P.A.O.-Corp.....

Remarks: Comb down 3 1/2" .....

.....

.....