


DATE _____

TOWN OF LEXINGTON — BOARD OF PUBLIC WORKS

WATER DIVISION

Sketch of Service Here

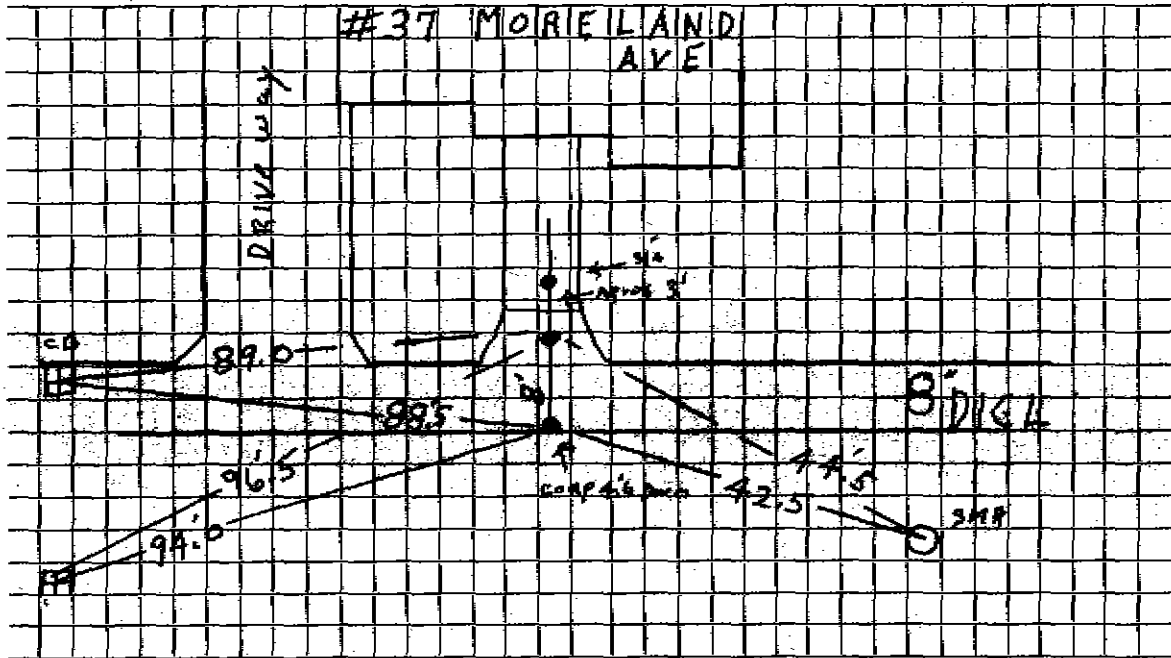

Connection made in _____ Street. Work completed _____

Remarks: Curb 4.9 Downy. Exit: 31.4 Curb left in place under brick walk. 47.6 From M.H.