


DATE _____

TOWN OF LEXINGTON — BOARD OF PUBLIC WORKS

WATER DIVISION

Sketch of Service Here

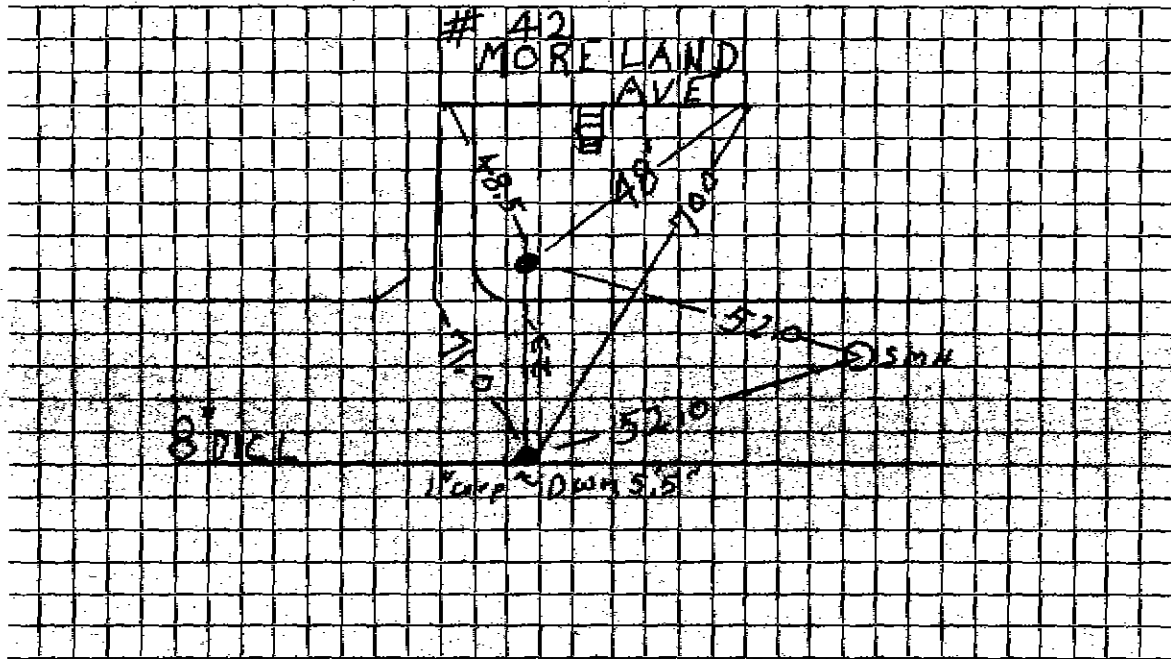

Connection made in Street Work completed 6/10/09 P.A.O. Corp.

Remarks: C.A. DOWN 4.8'