




DATE \_\_\_\_\_

TOWN OF LEXINGTON — BOARD OF PUBLIC WORKS

**WATER DIVISION**

Sketch of Service Here

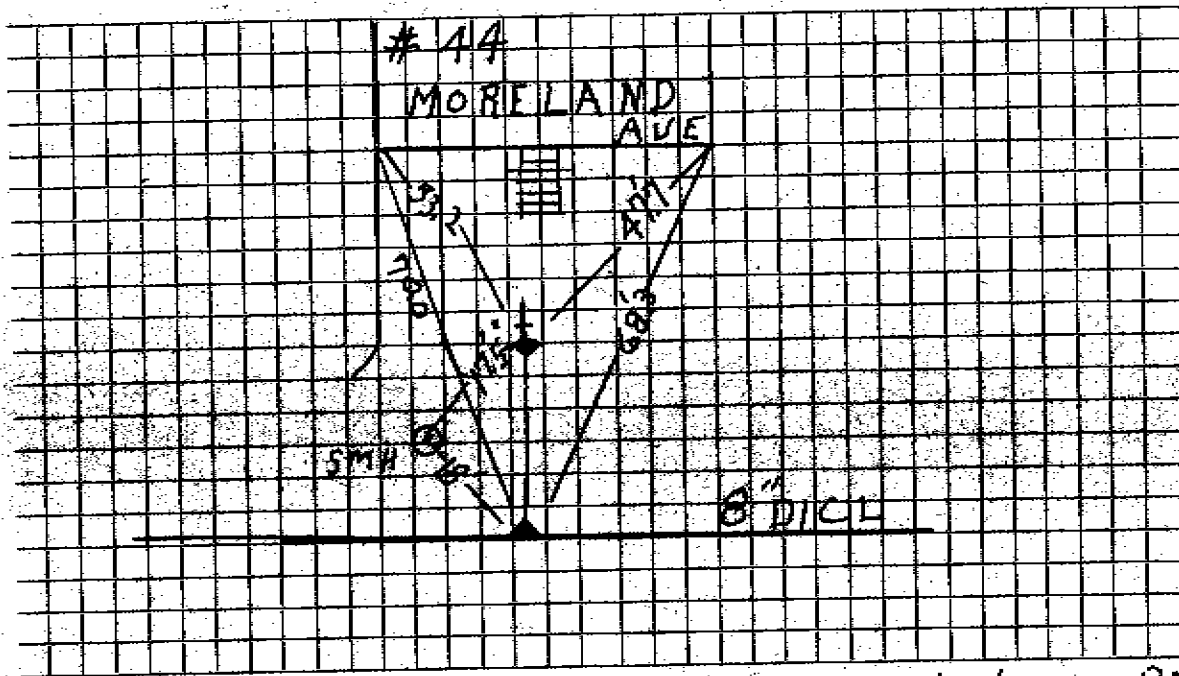

Connection made in ..... Street.

Work completed 6/10/09 PRO Corp

Remarks: Curb Down 6, 1" / corp?