

WATER SERVICE RECORD

Name J. G. Realty Trust

Service No. 55

Address 2 Morgan Road

Location

Repair—Renewal—New Service

Work Order # 4916 John Devine Permit #2874

MAY 9 1977


Date		Material	Amount		Total		Date	Amount	
10/4/76		Labor	63	41			<i>9-28-76</i>	<i>Deposit</i>	<i>300 00</i>
		10% OH	6	34	69	75	<i>5-9-76</i>	<i>Refund</i>	<i>150 88</i>
	17'	1" Copper @ .83			14	11			<i>149 12</i>
	1	1" Corp			16	69			
	1	1" Curb			18	67			
	1	Box & Rod			15	40			
	1/2	Hr. Trucking @ 3.00			1	50			
	2	Hrs. Shovel @ 6.50			13	00			
					149	12			
12/1/76	58'	1" copper							

DATE _____

TOWN OF LEXINGTON — BOARD OF PUBLIC WORKS

WATER DIVISION

Sketch of Service Here

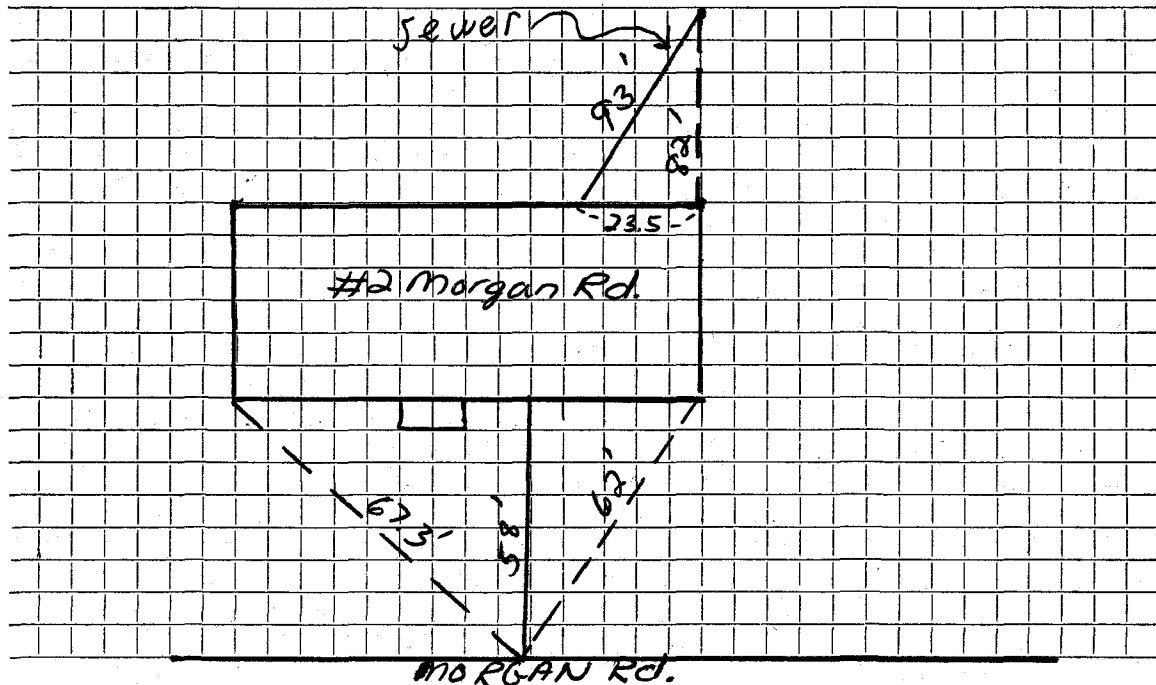

Connection made in Street. Work completed

Remarks: 9.3' 4" C.I. See sewer Tie

.....
.....