


DATE 10-17-01

TOWN OF LEXINGTON — BOARD OF PUBLIC WORKS

WATER DIVISION

Sketch of Service Here

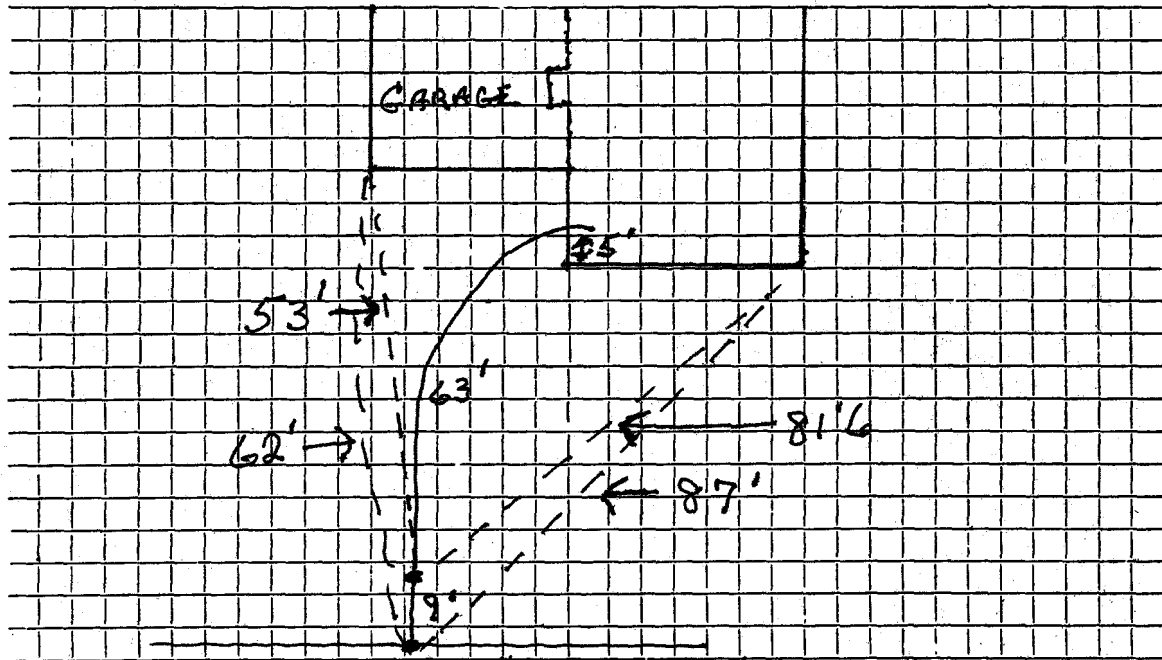


Connection made in ... MORRIS ... Street. 2" COPPER MAIN Work completed

Remarks: INSTALLED BY J. McLAUGHLIN
CONNECTED TO 2" COPPER MAIN

TOWN OF LEXINGTON — BOARD OF PUBLIC WORKS

WATER DIVISION

Sketch of Service Here

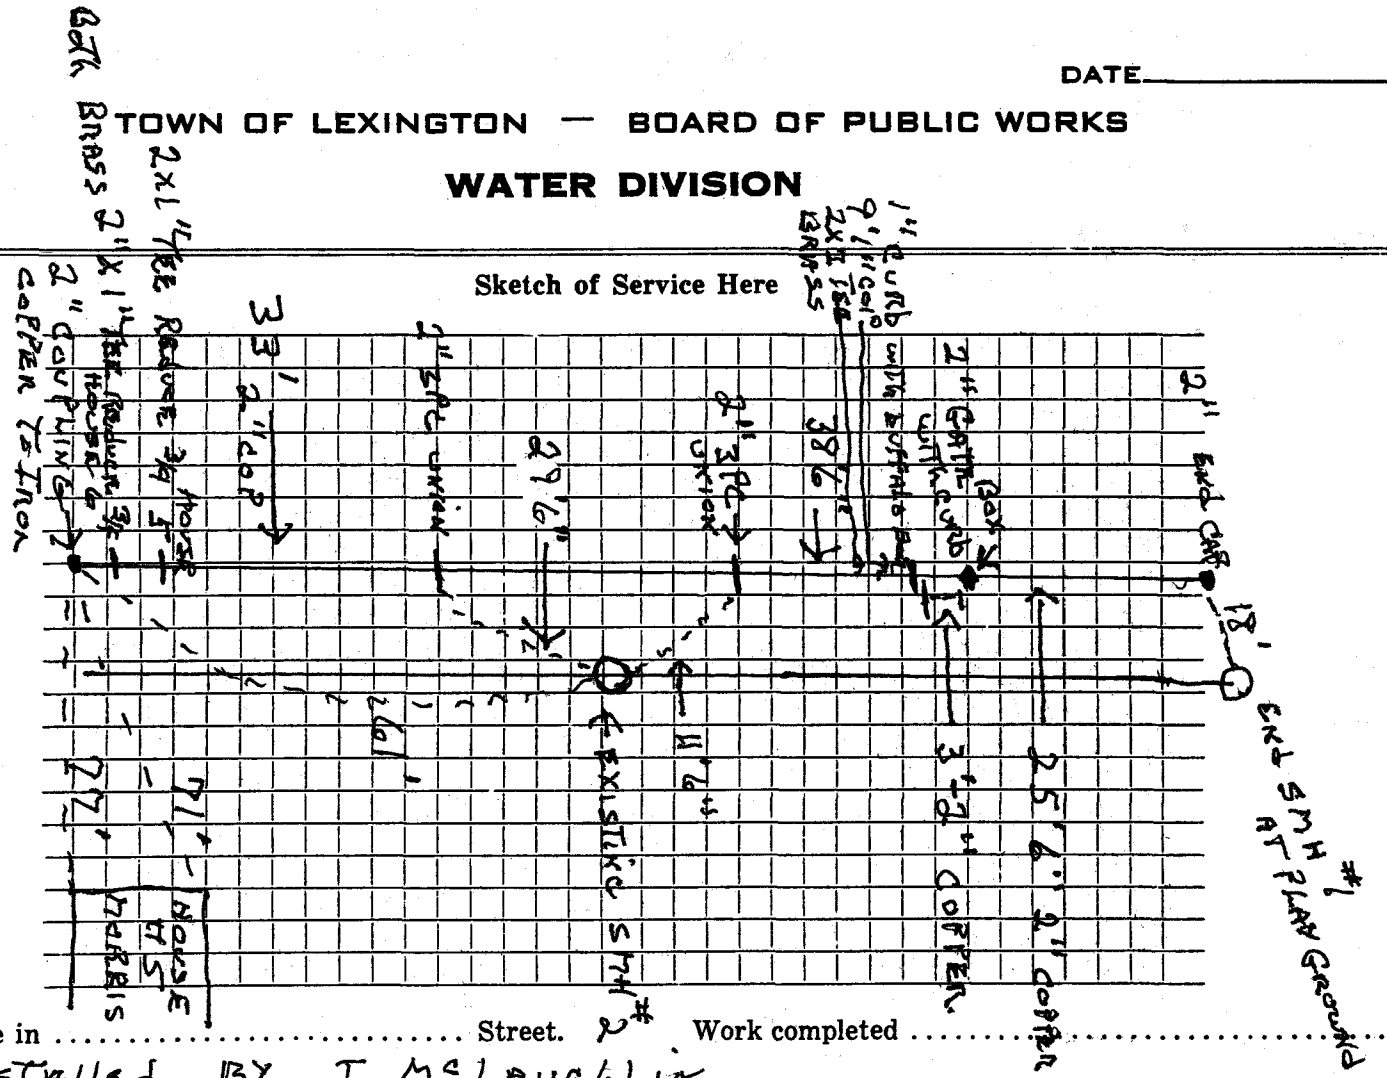

Connection made in Street. Work completed

Remarks: Installed BY J. McLaughlin