

WATER SERVICE RECORD

1364

Service No. 12

Name Francis Benoit

Address 2 Morris Street

Location Lexington

~~Repair/Reconnect~~ - New Service COM. 4-28-52


Date	Material	Amount	Total	Date	Amount
3/14/52	Labor	2 98	2 98	2-4-52	Deposited 35 10
	10% overhead		30	6-30-52	Paid 17 66
	60' - 3/4" copper tubing @ .3439	20 63			<u>NON CHARGE</u> 42 66
	1 - 3/4" C x 1/2 I.W.H. stop & waste	4 00		3/14/52	Labor 18 42
	2 hrs. Littlefield shovel @ 7.	14 00		3/15/52	" 16 05
	1 hr. trucking		75	52' - 3/4" copper tubing @ .3439	17 88
			42 66	1 - 3/4" C. corp-cock	4 33
				1 - 3/4" C x 3/4" C. curb-cock	4 67
				1 box and rod	4 52
				1 - 1/2 straight tail piece	50
				1 - 1/2 offset tail piece	50
				4 hrs. Littlefield shovel @ 7.00	28 00
				1 hr. trucking	75
					<u>95 62</u>
					bill sent 4-25-52

DATE _____

TOWN OF LEXINGTON — BOARD OF PUBLIC WORKS

WATER DIVISION

Sketch of Service Here

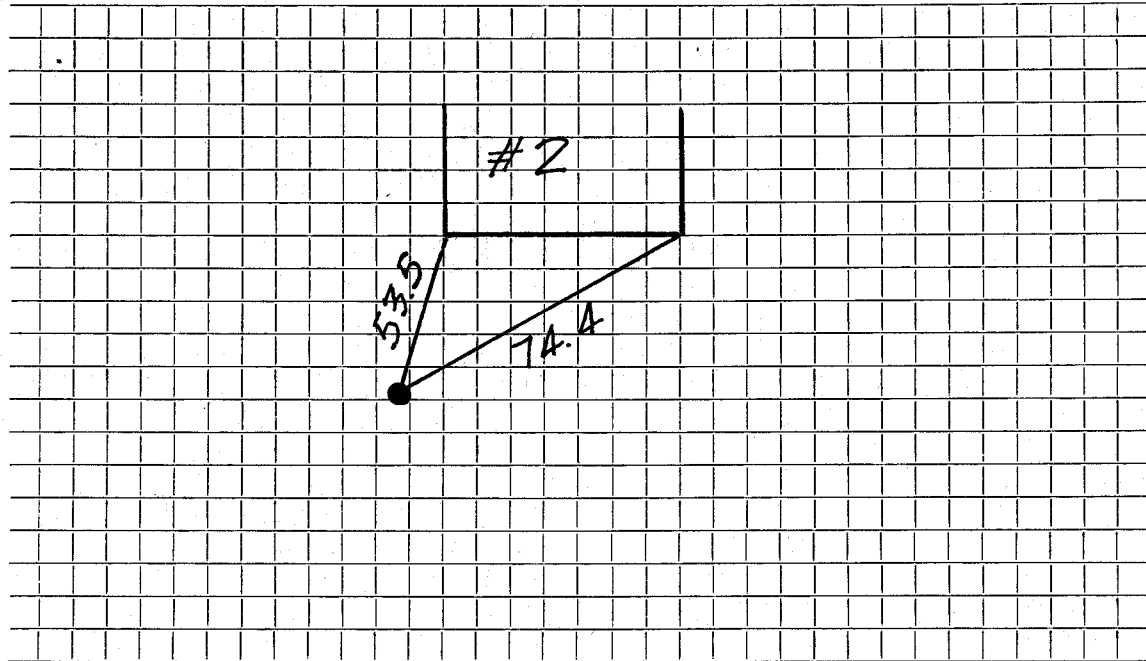

Connection made in Street. Work completed

Remarks:
.....
.....