

WATER SERVICE RECORD

Name William J. Weisensee

Service No. 186

Address 4 Morris Street

Location

~~REPAIR~~ - New Service

Case 9-17-54


Date	Material	Amount	Total	Date	Amount
8/3/54	Labor	1 85		8-4-54	Deposited 20 00
	10% overhead	19	2 04	9-13-54	Refunded (2 71)
	30' - 3/4" copper tubing@ .35		10 50		<u>NON CHARGE</u> 17 27
	1 - 3/4"C x 1/2 I.W.H. stop & waste		4 00	8/3/54	Labor 6 51
	1 hr. trucking		75	10'	- 3/4" copper tubing@.35 3 50
			17 29	1 - 3/4"C union	1 09
	TRENCH DUG BY OWNER:			1 -3/4"C x 3/4"C. curb-cock	4 67
				1 box and rod	3 90
				1 -1/2straight tail piece	50
				1 -1/2offset tail piece	50
				1/2 hr. Littlefield shovel@ 7.50	3 75
				1 hr. trucking	75
					<u>25 17</u>

DATE _____

TOWN OF LEXINGTON — BOARD OF PUBLIC WORKS

WATER DIVISION

Sketch of Service Here

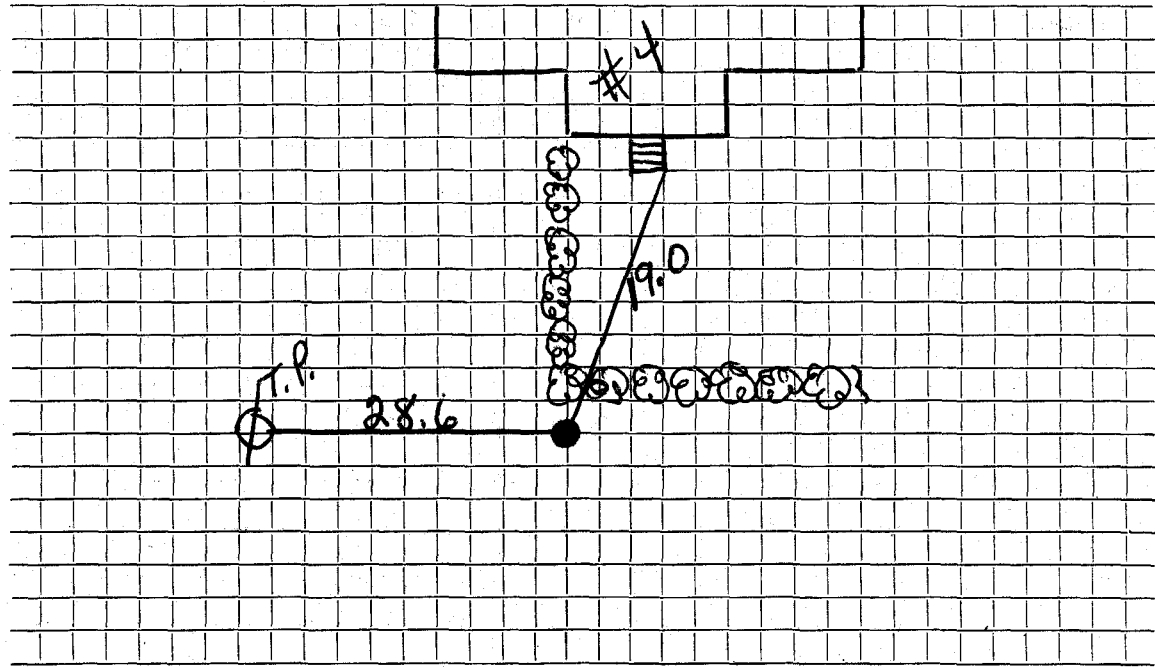

Connection made in Street. Work completed

Remarks:
.....
.....