

WATER SERVICE RECORD

Name Salvatore Capotosto

Service No.

179

Address 5 Morris St. (garden pit)

Location

5 Morris St. New House

~~REPAIR WORK~~ - New Service

Com. 9-13-54


Date	Material	Amount	Total	Date	Amount
8/4/54	Labor	13 30		8-4-54 Deposited	25 00
	10% overhead	1 33	14 63	9-13-54 Refunded	(2 12)
	10' - 3/4" copper tubing @ .35	3 50		<u>NON CHARGE</u>	22 88
	1 - 3/4" C x 1/8" I.W.H. stop & waste	4 00	8/3/54 Labor		8 36
	1 hr. trucking		75	32' - 3/4" copper tubing @ .35	11 20
			22 88	1 - 3/4" C x 3/4" I. union	1 09
12/7/78	62' 3/4" Copper tubing			1 - 3/4" C x 3/4" C. curb-cock	4 67
				1 box and rod	3 90
				2 - 1/2 straight tail pc. @ .50	1 00
				250 cement brick @ 27/M	6 75
				1 pit cover and frame	9 88
				2 hrs. Littlefield shovel @ 7.50	15 00
				1 hr. trucking	75
					<u>62 60</u>

DATE _____

TOWN OF LEXINGTON — BOARD OF PUBLIC WORKS

WATER DIVISION

Sketch of Service Here

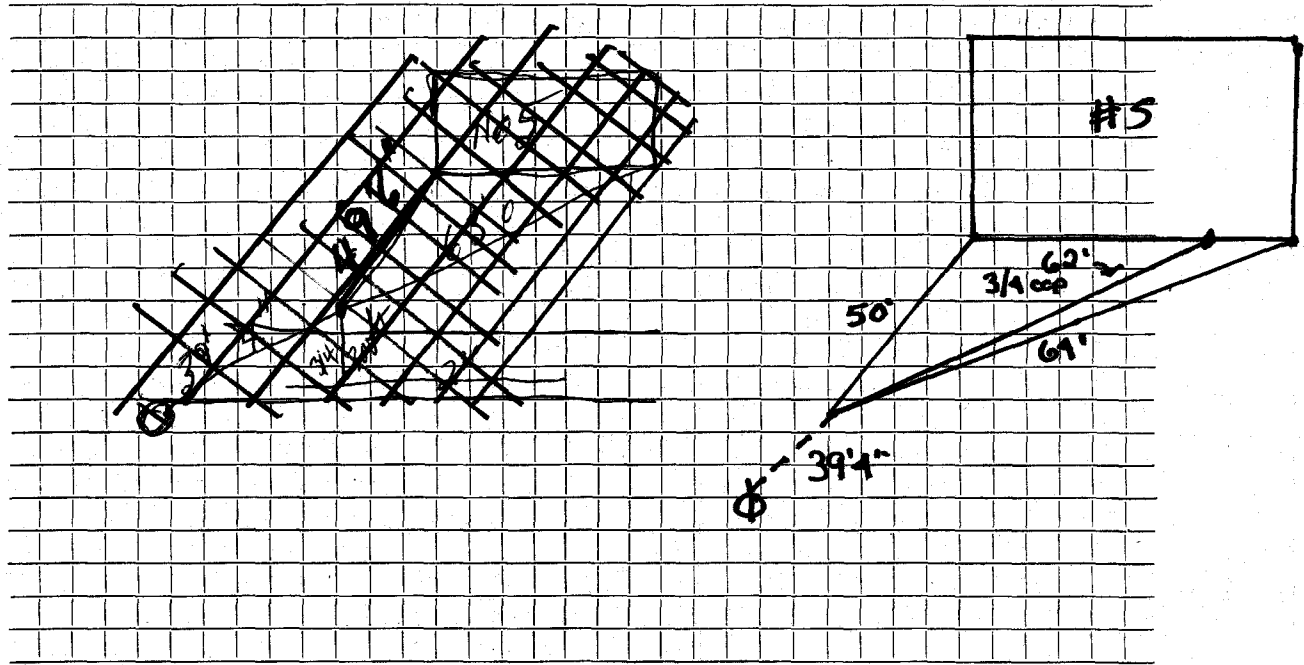

Connection made in Street. Work completed

Remarks: *W.P.W. Service 1978*

.....
.....