


DATE 11/30/2018

TOWN OF LEXINGTON — BOARD OF PUBLIC WORKS

WATER DIVISION

Sketch of Service Here

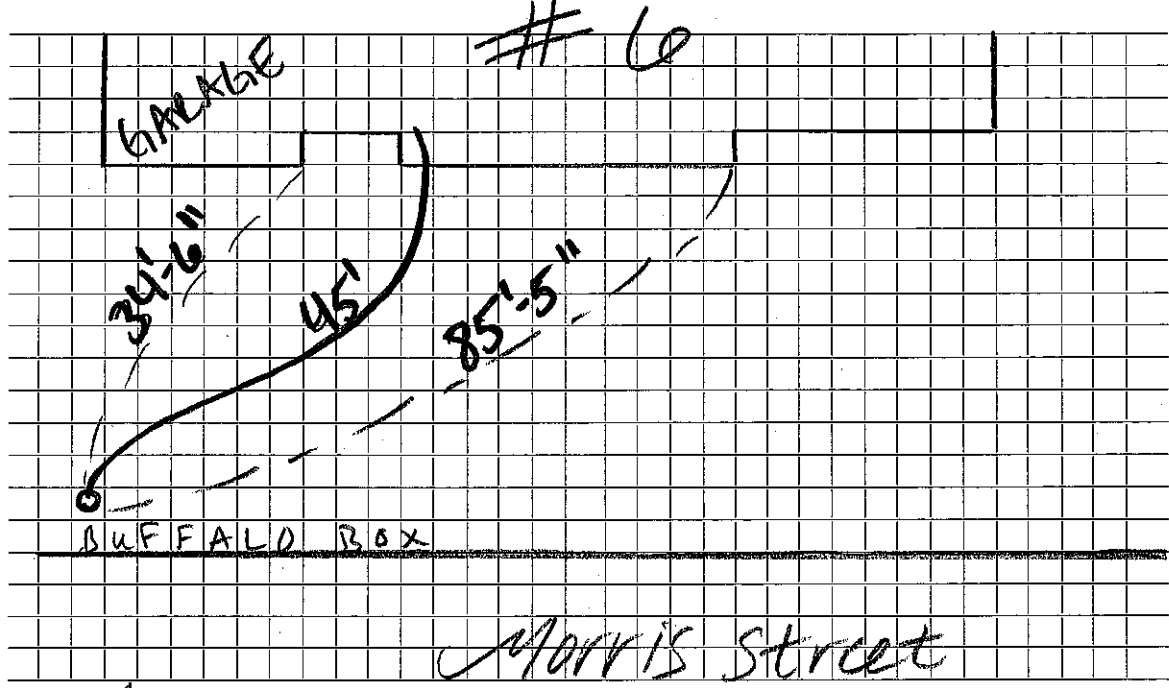

Connection made in Morris Street. Work completed

Remarks: Inspected by MW, ties by ML