

WATER SERVICE RECORD

Name PAUL CASTEMAN

Service No.

Address

Location 7 MOUNTAIN RD.


Repair—Renewal—New Service LEX. SEWERAGE CO. # 3954

Date	Material	Amount	Total	Date	Material	Amount	Total
11-8-79	384' 2" COPPER STARTING AT CURB UNIONS ARE 45' APART.			11/8/79	19' 2" COPPER 8"x2" SERVICE SADDLE 2" CORP. 2" ORISEAL CURB RD WAY BOX		
	156' 1" COPPER						
	3 1" UNIONS						
	1 2"x1 1/2" COMP. REMOVED - 2"x1" WYE INST.						
12/14/79	40' 1" COPPER						
	1 1" CURB STOP						
	1 Box + Rod						

TOWN OF LEXINGTON — BOARD OF PUBLIC WORKS

WATER DIVISION

Sketch of Service Here

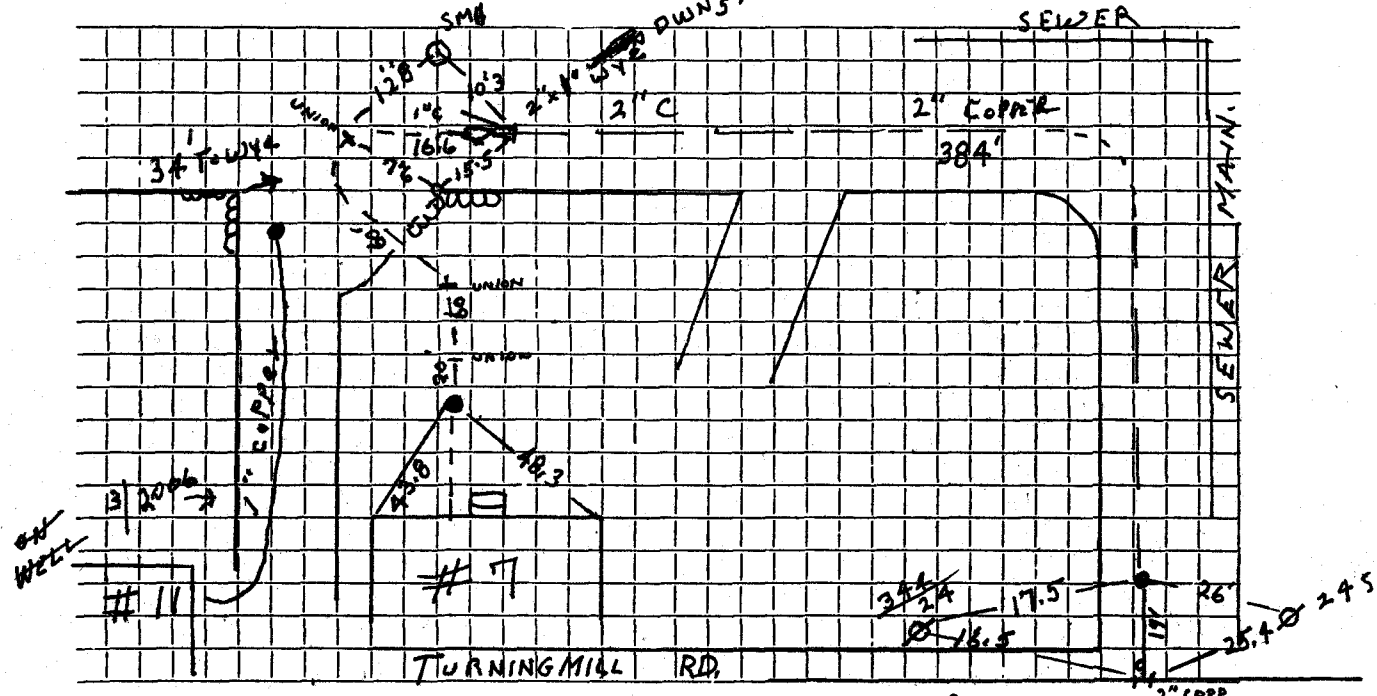

Connection made in TURNING MILL RD...... Street. Work completed (Repairs MADE 12/17/99) SAME NUMBERS.

Remarks: THERE IS ~~NO~~ CONNECTION OFF THIS SERVICE FOR HOUSE NO. 11 - (2" x 1" WYR INST. 2006) REDMOND.

. STARTING AT CURB 2" UNIONS ARE 45' APART. ... WATER SERVICE OVER SEWER SERVICE DRIVEWAY AREA 2 TIMES