




DATE 10-18-01

TOWN OF LEXINGTON — BOARD OF PUBLIC WORKS

JACKS Birthday

WATER DIVISION

Sketch of Service Here

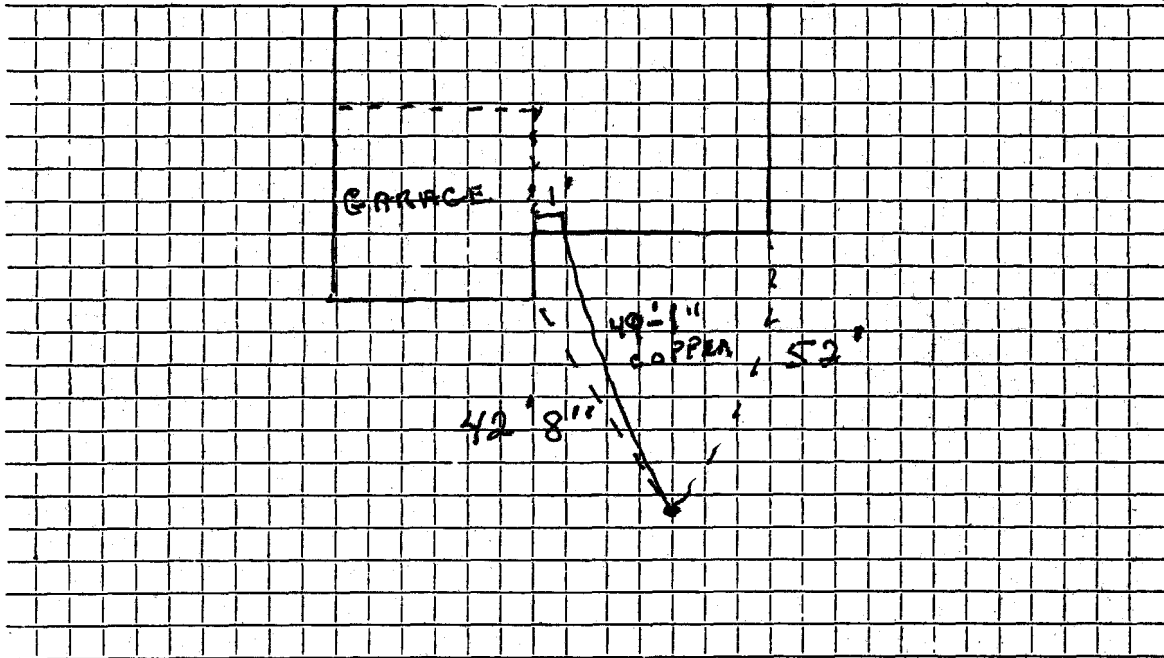

Connection made in M. V. ROE Street. Work completed MAY 25, 2001

Remarks: Installed BY J. McLAUGHLIN