




DATE \_\_\_\_\_

TOWN OF LEXINGTON — BOARD OF PUBLIC WORKS  
WATER DIVISION

Sketch of Service Here

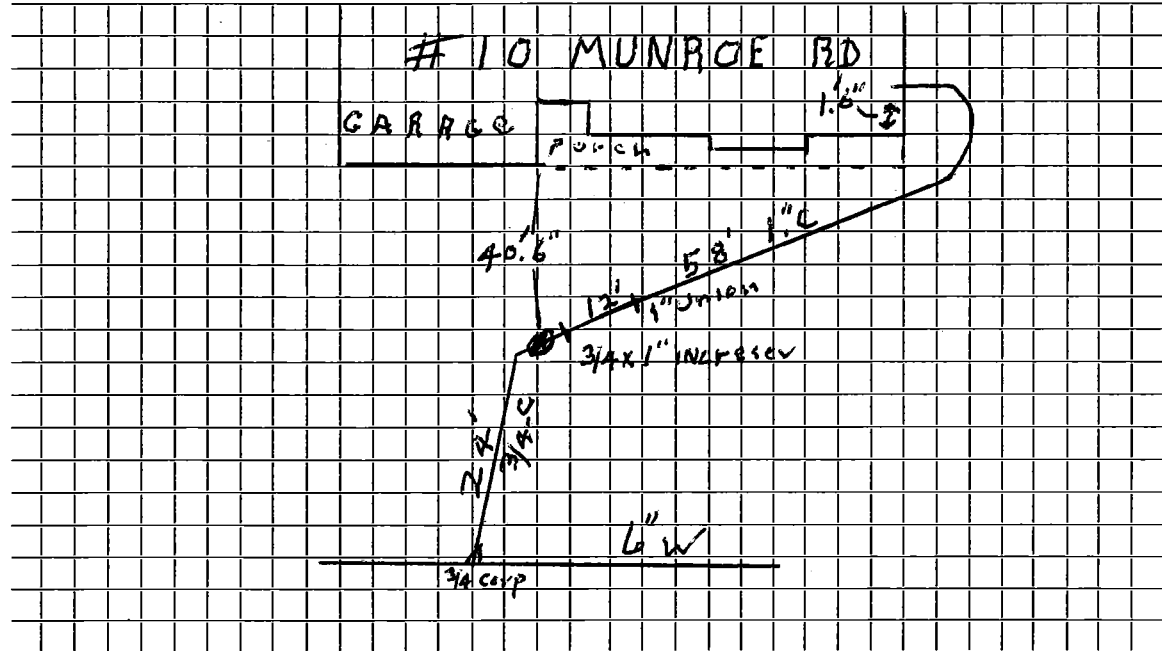

Connection made in..... Street. Work completed 12/5/10.....

Remarks:.....  
.....  
.....