

Name Custom Built Homes

2328  
Service No. 108 3220

Address 13 Munroe Road

Lexington, Mass.

Location 13 Munroe Road

Kind of Pipe

Size

Size of Main

~~Repair~~ ~~Renewal~~ — New Service

Com. 12-10-46

Location

Date	Material	Amount	Total	Date	Location	Amount
Nov. 30, '46	Labor	19 44	19 44	Nov. 25 '46	Deposited	40 00
	10% Overhead		1 94	Dec 31 '46	Refunded	6 74
	36' - 3/4" Copper Tubing @.23	8 28	8 28		Non-Charge	33 26
	1 - 3/4" C x 1/2" I.W.H. Stop & Waste	2 82	2 82	Nov. 30, '46	Labor	7 56
	1 - 3/4" C x 3/4" C Union (2 parts)	78	78	14' - 3/4" Copper Tubing @.23		3 22
			33 26	1 - 3/4" C Corp-cock		2 70
				1 - 3/4" C x 3/4" C Curb-cock		3 30
				1 - Box & Rod		3 30
				1 - 1/2" Offset Tail Piece		50
				1 - 1/2" Straight Tail Piece		50
						21 08
	Labor					

Hadley Press, Inc., Lexington

DATE \_\_\_\_\_

# TOWN OF LEXINGTON—BOARD OF PUBLIC WORKS

## WATER DIVISION

The undersigned applies for a supply of water at No. \_\_\_\_\_ St. and hereby agrees to comply with the rules and regulations as now, or at any future time, established by the Board of Selectmen.


Am't. of Estimate \$ \_\_\_\_\_

Owner \_\_\_\_\_

Am't. Paid \$ \_\_\_\_\_

Address \_\_\_\_\_

Builder \_\_\_\_\_

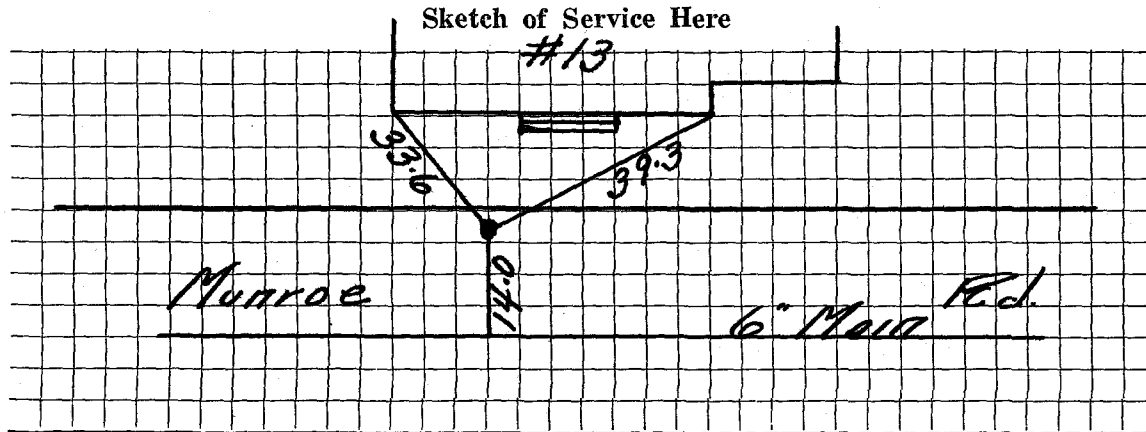

Connection made in \_\_\_\_\_ Street.

Work completed \_\_\_\_\_ 19

Remarks: