

Name Custom-Built Homes

Service No. 108 3216

Address 14 Munroe Road

#1965

Lexington, Mass.

Location 14 Munroe Road

Kind of Pipe

Size

Size of Main

~~Repair~~ ~~Renewal~~ New Service

Com. 12.16.46

Location

Date	Material	Amount	Total	Date	Amount
Nov. 30, '46	Labor	21 60	21 60	Nov. 25 '46	40 00
	10% Overhead		2 16	Dec 31 '46	4 22
	40' - $\frac{3}{4}$ " Copper Tubing @ .23		9 20		36 78
	1 - $\frac{1}{4}$ " C x $\frac{1}{2}$ " I.W.H. Stop & Waste	2 82	35 78	Nov. 30, '46	14 04
				26' - $\frac{3}{4}$ " Copper Tubing	5 98
				1 - $\frac{3}{4}$ " C Corp-cock	2 70
				1 - $\frac{3}{4}$ " C x $\frac{3}{4}$ " C Curb-cock	3 30
				1 - $\frac{3}{4}$ " C x $\frac{3}{4}$ " C Union (2 parts)	78
				1 - Box & Rod	3 30
				1 - $\frac{1}{2}$ " Straight Tail Piece	50
				1 - $\frac{1}{2}$ " Offset Tail Piece	50
					31 10
	Labor				

Hadley Press, Inc., Lexington

DATE _____

TOWN OF LEXINGTON—BOARD OF PUBLIC WORKS

WATER DIVISION

The undersigned applies for a supply of water at No. _____ St. and hereby agrees to comply with the rules and regulations as now, or at any future time, established by the Board of Selectmen.

Am't. of Estimate \$ _____


Owner _____

Am't. Paid \$ _____

Address _____

Builder _____

Sketch of Service Here

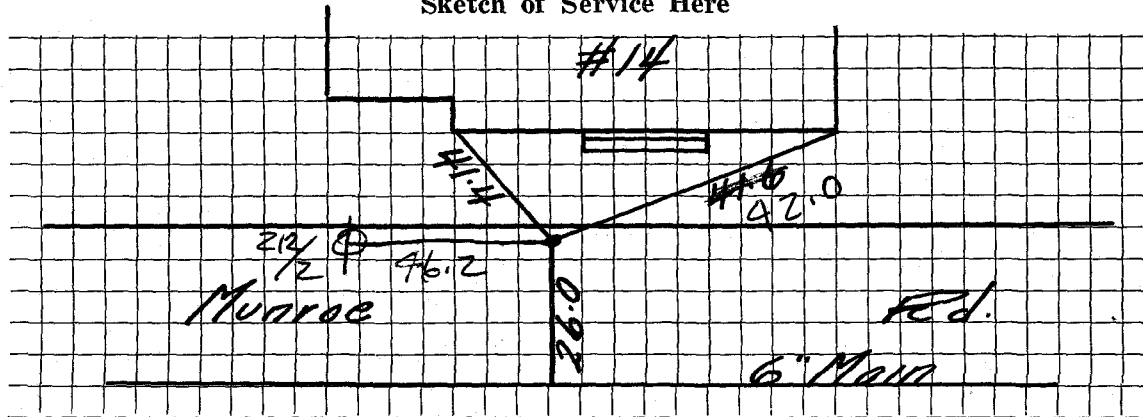

Connection made in _____ Street.

Work completed _____ 19

Remarks: